




ESTIMATED LEASE AREA
13,046 TOTAL SQ. FT.

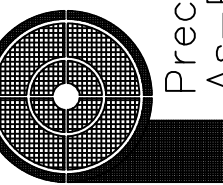

Essential Service for
Architects, Builders,
Retailers, etc...

Precision Architectural
AS-Builts

Phone: (303) 625-9900
Fax: (616) 307-5663
Email: support@psurveys.com
P.O. Box 19039
Denver, CO 80219

155 MOUNT VIEW LANE
COLORADO SPRINGS, CO.
SUITES 125-155

BROCKMAN GROUP



730 KALAMATH STREET
DENVER, COLORADO 80204
PHONE: 303-900-9111

ISSUE DATE:
02/07/23


PROJECT NO 23341
DRAWN BY KM/BM
REVISED BY CWB

FLOOR
PLAN


A1.0

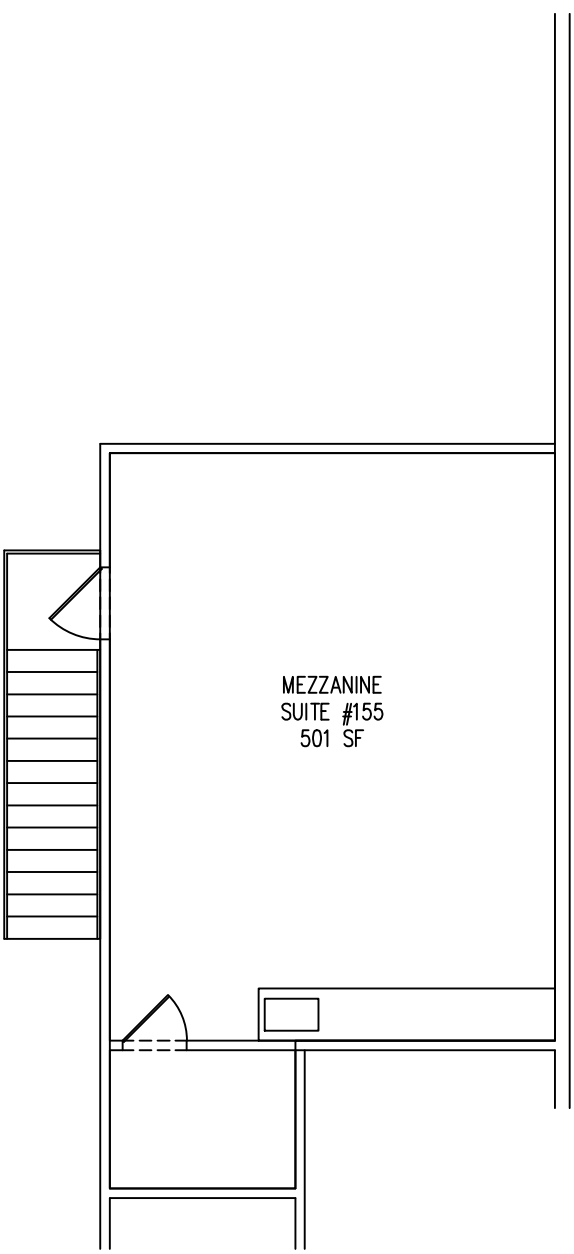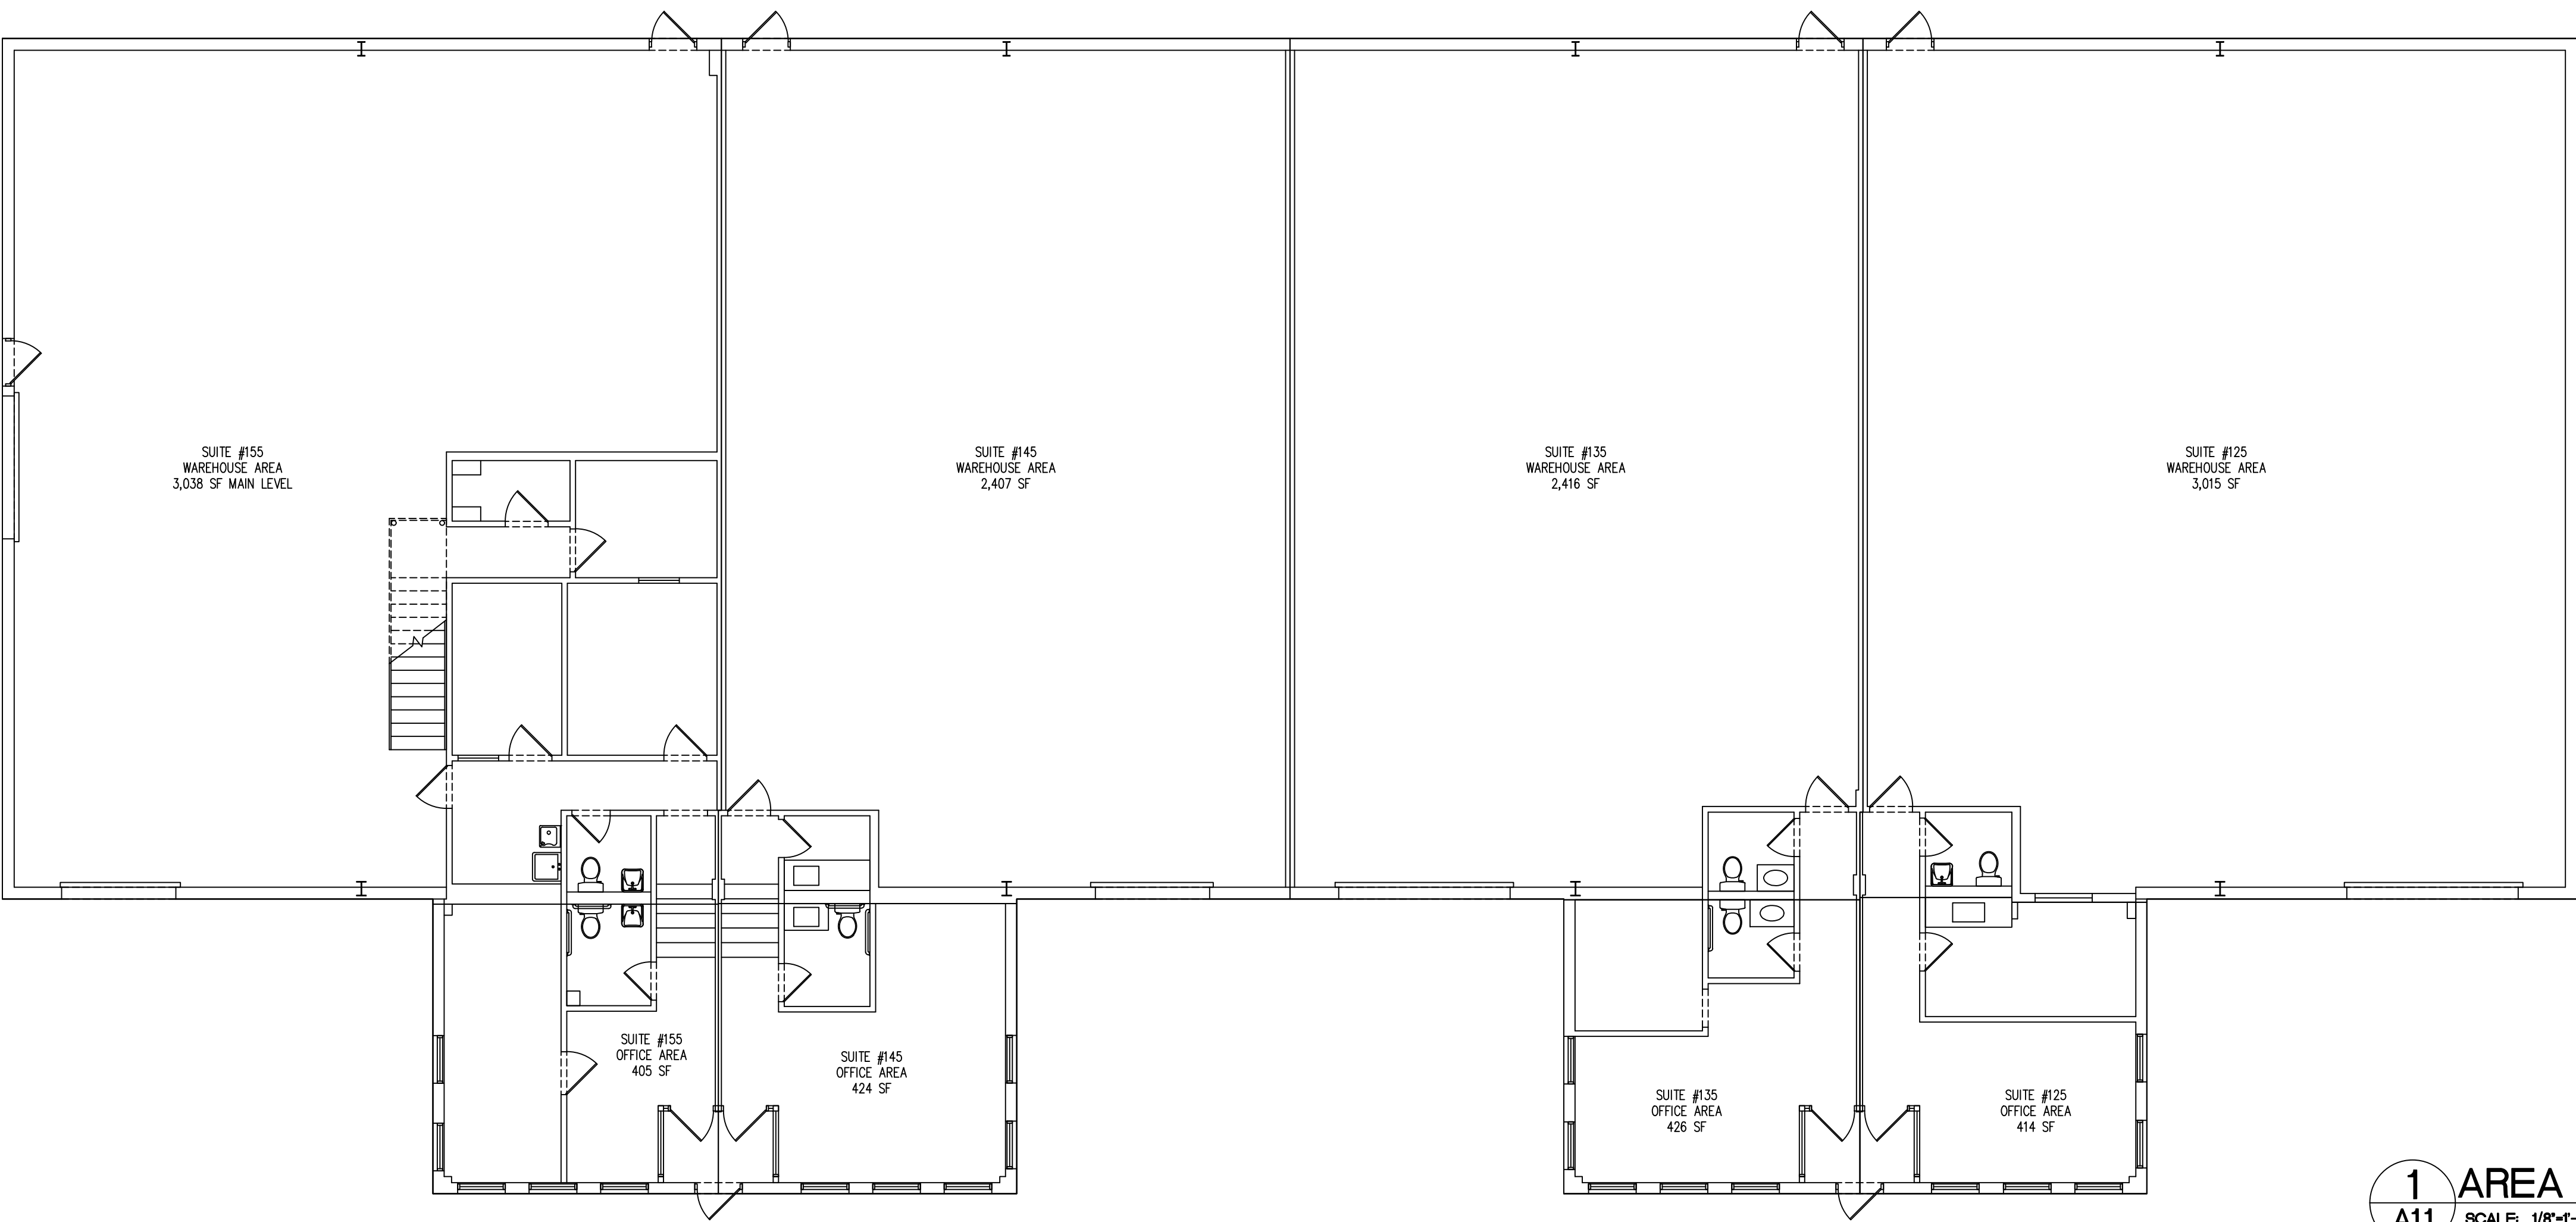

ESTIMATED LEASE AREA
13,046 TOTAL SQ. FT.

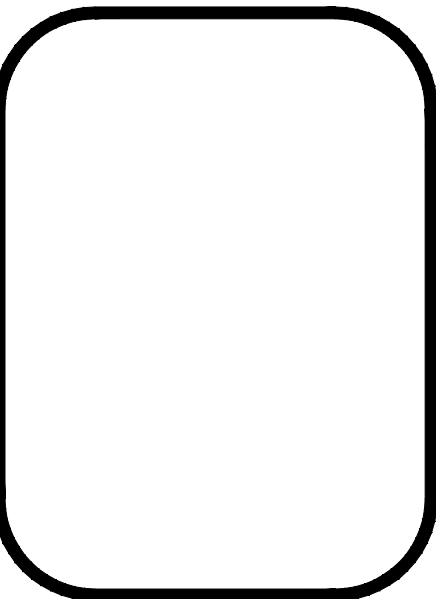

Essential Service for
Architects, Builders,
Retailers, etc...

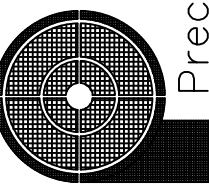

Precision Architectural
AS-Built
Phone: (303) 625-9900
Fax: (616) 307-5663
Email: support@psurveys.com
P.O. Box 19039
Denver, CO 80219

155 MOUNT VIEW LANE
COLORADO SPRINGS, CO.
SUITES 125-155

BROCKMAN GROUP
730 KALAMATH STREET
DENVER, COLORADO 80204
PHONE: 303-900-9111

ISSUE DATE:
02/07/23

PROJECT NO 23341
DRAWN BY KM/BM
REVISED BY CWB

AREA
PLAN

A1.1