

SSDS AS-BUILT LOCATION


N ←

BERTELSEN

268 Main Street

septic tank replacement

5/17/07

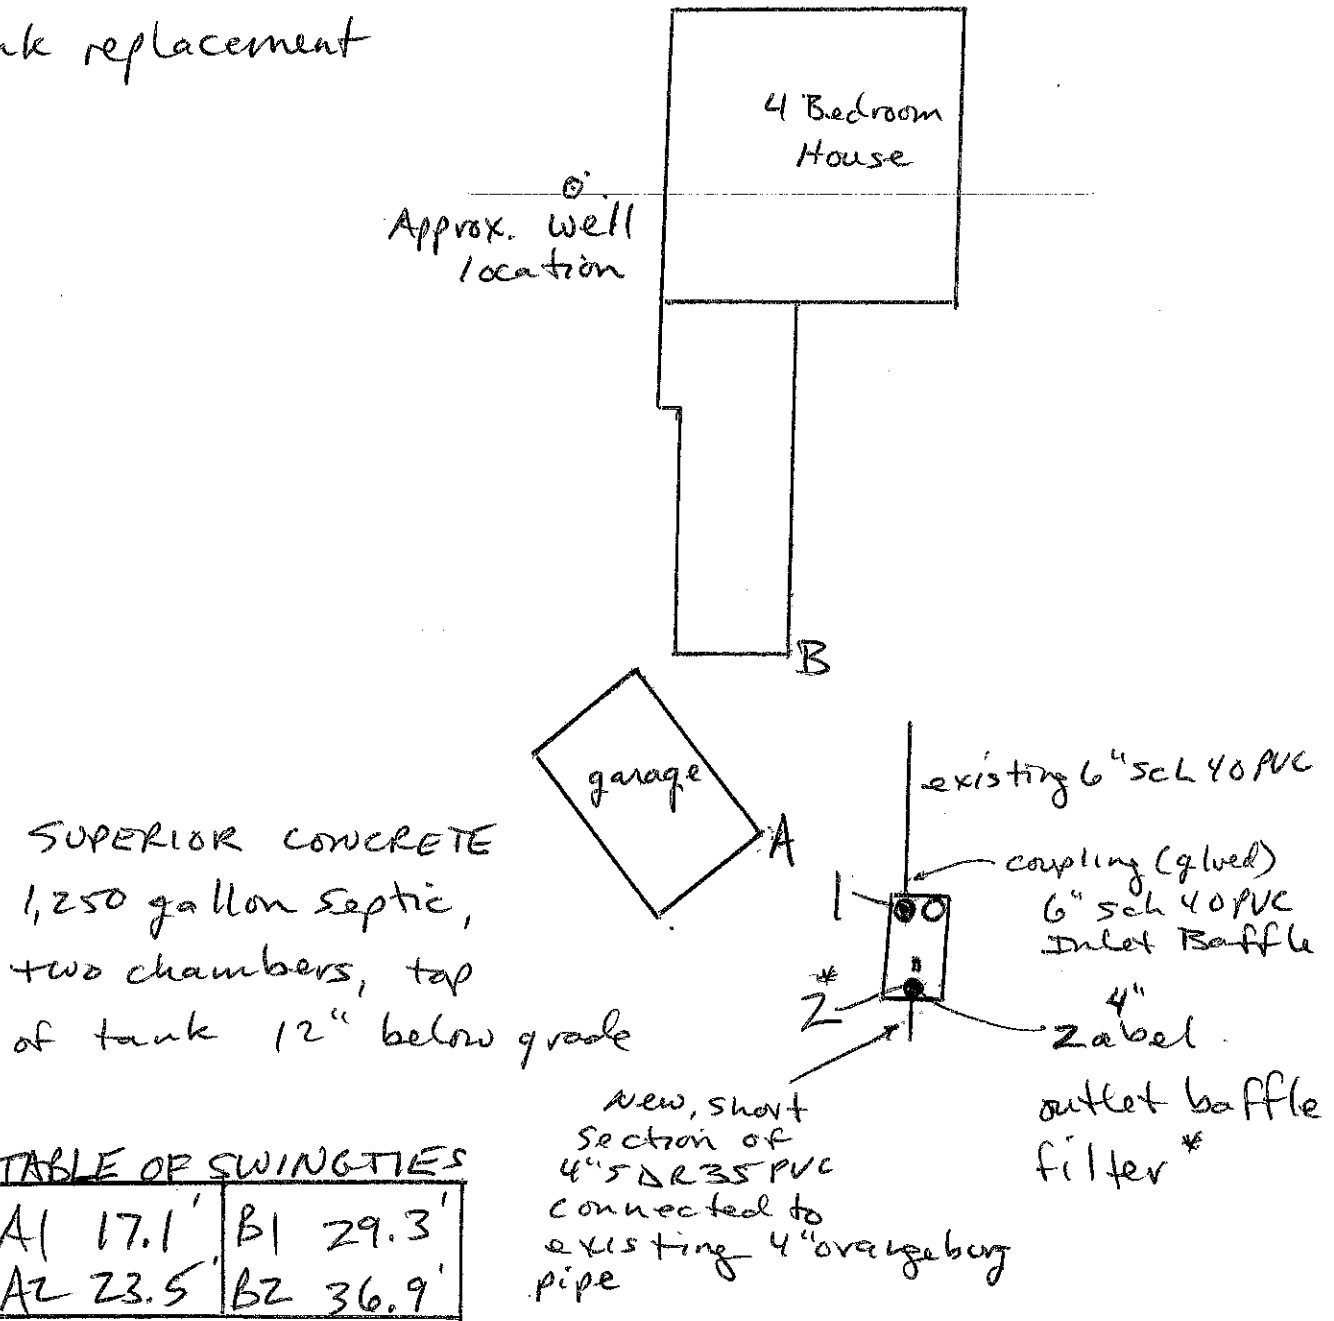

* requires periodic
maintenance