

# The District Health Department

CASWELL - CHATHAM - LEE - PERSON COUNTIES

## Water Supply and Sewage Disposal

IMPROVEMENTS PERMIT No. 118

Date 7/18/84

Owner: Dutton G. Stoy

Location: SR 154 1/4 S. of Orange Co. Line approx 1 mile off SR 1539 and to drive to left

Contractor: \_\_\_\_\_

Water Supply: Private  Public \_\_\_\_\_

Sewage Disposal Facilities: No. bedrooms \_\_\_\_\_ Dishwasher, Disposal, washing machine, other automatic appliances \_\_\_\_\_

Size of tank: \_\_\_\_\_ Nitrification line: 100 ft

Other disposal facility: \_\_\_\_\_

Water supply and sewage disposal facilities location, installation and protection must meet state and local regulations.

Septic tank should be pumped out every 3 to 5 years and shall be maintained by owner in such a manner as not to create a public health hazard. Septic tank and nitrification line MUST BE INSPECTED AND APPROVED BY A MEMBER OF THE DISTRICT HEALTH DEPARTMENT STAFF BEFORE ANY PORTION OF THE INSTALLATION IS COVERED AND PUT INTO USE.

Date approved: \_\_\_\_\_ Signed Virginia Lynn Sanitarian

Well: \_\_\_\_\_

Sewage Disposal: \_\_\_\_\_

By: \_\_\_\_\_ County signed (Owner or his representative)

Showered 6/11/86 TA

Certificate of Completion


Date Approved: 1-19-87 By: Karen Davis Sanitarian

(OVER)

Location of well and sewage disposal facilities sketched on back.

Map Lot Block Stoy, Dutton

NOTE: Make sketch of installation showing lot size and shape, location of house, septic tanks, privies, water supplies, etc. Note special problems existing on lot. Write in measurements in order that installations may be located at later date. Note location of water supplies on adjacent lots.

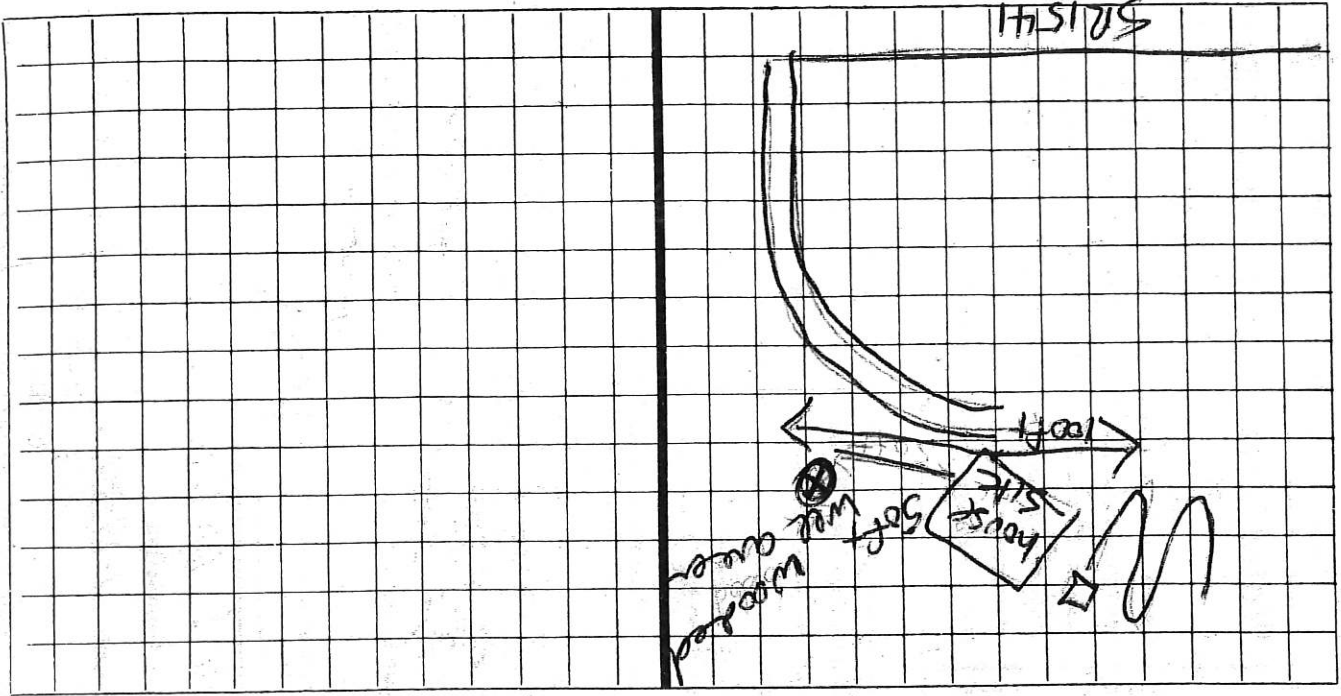

(2)

(1)

DATE: Dutton Stay  
OWNER: 10/11/86  
ADDRESS: SR 1541  
DRILLING CONTRACTOR: Shelton Well Drilling, VA

WELL CERTIFICATION  
COUNTY: Chatham  
ROAD/STREET: \_\_\_\_\_  
PERMIT NO. VR-118  
NAME \_\_\_\_\_ ADDRESS \_\_\_\_\_

WELL CONSTRUCTION  
Distance from Nearest Property Line 10' Distance from Source of Pollution 100'  
Total Depth: 160 Ft. Yield: 7 GPM Static Water Level: 20 Ft.  
Water Bearing Zones: Dept: 7 @ 20 Ft. \_\_\_\_\_ Ft. \_\_\_\_\_ Ft. \_\_\_\_\_ Ft.  
Casing: Depth: From 0 to 22 Ft. Diameter: 10 1/4 Inches  
TYPE: Steel \_\_\_\_\_ Galvanized Steel  If Steel, does owner approve: Yes \_\_\_\_\_ No \_\_\_\_\_  
Weight: 1316/4 Thickness: .188 Height Above Ground: 12 Inches  
Drive Shoe: Yes:  NO: \_\_\_\_\_  
Were Problems Encountered in Setting the Casing? Yes \_\_\_\_\_ No   
If "yes" give reason: \_\_\_\_\_

Grout: Type: Neat \_\_\_\_\_ Sand/Cement? \_\_\_\_\_ Concrete \_\_\_\_\_  
Annular Space Width 3 Inches Water in Annular Space: Yes \_\_\_\_\_ No   
Method: Pumped \_\_\_\_\_ Pressure \_\_\_\_\_ Poured   
Depth: From 0 to 20 Ft.  
Materials Used: No. Bags Portland Cement 2 Weight of 1 bag 94 lbs.  
If mixture (sand, gravel, cuttings) - Ratio: 1/2 to \_\_\_\_\_  
ID Plates: Yes  No  Chlorination: Yes  No \_\_\_\_\_ 4 x 4 slab Yes  No \_\_\_\_\_

DRILLING LOG

Depth	Formation Description
From <u>0</u> to <u>20</u>	<u>2014</u>
<u>20</u> to <u>160</u>	<u>BLUE/GREY ROCK</u>

I HEREBY CERTIFY THAT THE ABOVE INFORMATION IS CORRECT AND THAT THIS WELL WAS CONSTRUCTED IN ACCORDANCE WITH REGULATIONS SET FORTH BY CASWELL-CHATHAM-LEE-PERSON DISTRICT HEA. DEPT.

James Shelton  
Signature of Contractor Date \_\_\_\_\_

FOR HEALTH DEPARTMENT USE ONLY

REASON FOR NO INSPECTION:

Tracy L. O'Hara 10/11/86  
Sanitarian's Signature Date

Sketch well location on reverse side. Use established reference points.

# The District Health Department

CASWELL - CHATHAM - LEE - PERSON COUNTIES

## Water Supply and Sewage Disposal

IMPROVEMENTS PERMIT No. VR-119

Date 7/10/84

Owner: Dutton C. Stoy

Location: SR 1541 1/4 m. S. of Orange

Co. line approx 1 mile off  
SR 1539 and to a drive to left

Contractor: \_\_\_\_\_

Water Supply: Private  Public \_\_\_\_\_

360 eqpd . 25 off water

Sewage Disposal Facilities: No. bedrooms 3 Dishwasher, Disposal, washing machine, other automatic appliances \_\_\_\_\_

Size of tank: 1200 Nitrification line: 480' x 3'

on contour max bench depth  
leave grass

Other disposal facility: 24" and sew in

Water supply and sewage disposal facilities location, installation and protection must meet state and local regulations.  
Septic tank should be pumped out every 3 to 5 years and shall be maintained by owner in such a manner as not to create a public health hazard. Septic tank and nitrification line MUST BE INSPECTED AND APPROVED BY A MEMBER OF THE DISTRICT HEALTH DEPARTMENT STAFF BEFORE ANY PORTION OF THE INSTALLATION IS COVERED AND PUT INTO USE.

Date approved: \_\_\_\_\_ Signed \_\_\_\_\_ Sanitarian

Well: \_\_\_\_\_

Sewage Disposal: \_\_\_\_\_

By: \_\_\_\_\_ Counter-signed \_\_\_\_\_ (Owner or his representative)

### Certificate of Completion

Date Approved: 8-5-86 By: [Signature] Sanitarian

(OVER)

Location of well and sewage disposal facilities sketched on back.

