


VICINITY MAP
NOT TO SCALE

LOT 11

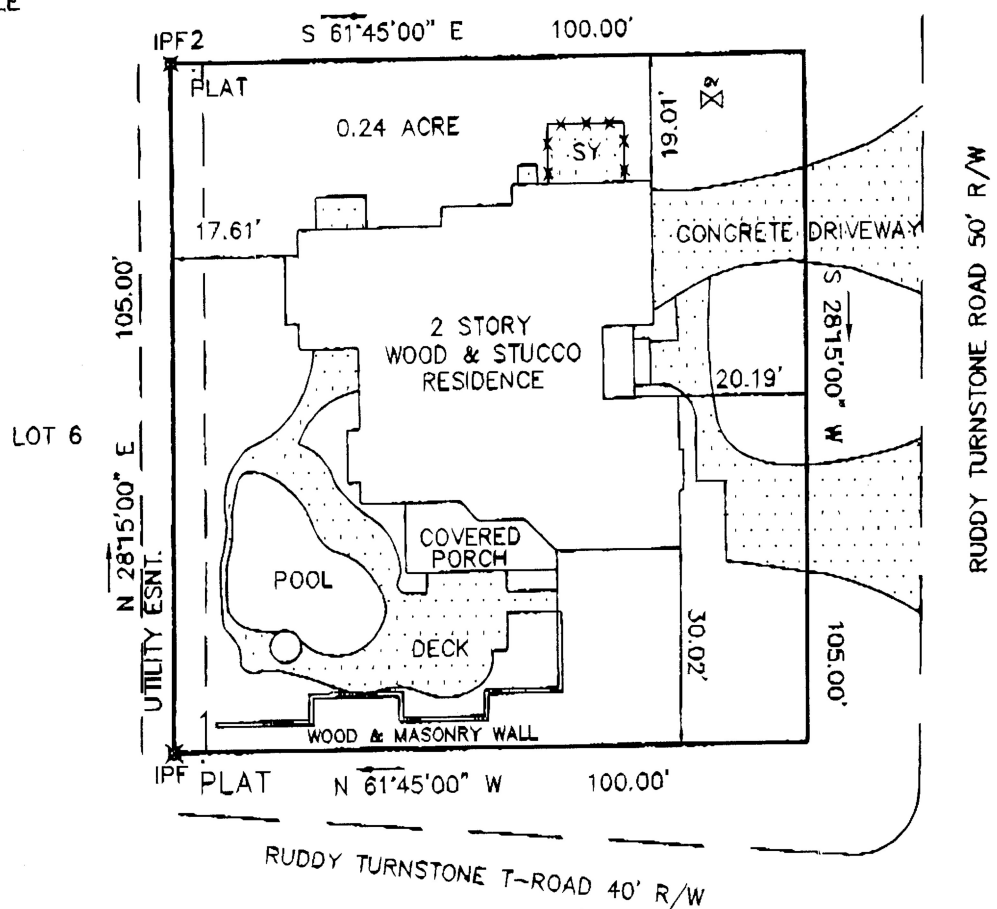

NOTE:
1) BUILDING PERMIT # B0403524
2) TAX ID# 550-18A-007

REFERENCE:
RUDDY TURNSTONE ROAD, SEA PINES PLANTATION
PLAT BOOK 12 PG. 97 DATE RECORDED 2-24-61

IPS ● IRON PIN SET	PP □ POWER POLE	SY □ GAS VALVE
IPF ○ IRON PIN FOUND	WOOD DECK	POL POINT ON LINE
CONC. O. □ CONCRETE MONUMENT FOUND	OE — OVERHEAD ELECTRIC LINE	ESMT EASEMENT
CONC. N. ■ CONCRETE MONUMENT SET	CONCRETE PAVING	SY SERVICE YARD
TEL ○ TELEPHONE BOX	EP — EDGE OF PAVEMENT	ELEC □ ELECTRIC TRANSFORMER
SBL — SETBACK LINE	BRICK/TILE/PAVERS	— x — FENCE
S/D SUBDIVISION		TV △ CABLE TV BOX
		WV □ WATER VALVE
		FH □ FIRE HYDRANT



AUGUST 10, 2005

ASBUILT SURVEY OF:
LOT 7 (#30 RUDDY TURNSTONE ROAD)
SEA PINES PLANTATION
HILTON HEAD ISLAND
BEAUFORT COUNTY SOUTH CAROLINA