

CAROLINE CALDERONE BAISLEY
DIRECTOR OF HEALTH



Department of Health
101 Field Point Road Greenwich, CT 06830
203-622-7838
www.greenwichct.org

DEPARTMENT OF HEALTH

SUBSURFACE SEWAGE DISPOSAL SYSTEM PERMIT TO DISCHARGE

Approval is hereby given to: HYUN CHUL HENRY & KIM for the Main House Located at: 29 HUNTING RIDGE ROAD in the Town of Greenwich to discharge to a subsurface sewage disposal system which will receive treated domestic sewage from the above dwelling containing 6 bedrooms or 675 gallons per day in accordance with Public Health Code Section 19-13-B103e (h).

Design Flow: 675 GPD / Permitted Volume: 675 GPD. Note: The design flow must be limited accordingly for any repaired system that has an undersized leaching system or where the naturally occurring soil has limited hydraulic capacity based on MLSS non-compliance. In order to provide a sufficient factor of safety it is recommended that the average daily discharge not exceed 2/3 of the design flow or **450 GPD.**

Operation and Maintenance: The septic tank shall be inspected regularly and cleaned not less frequently than every five years. The septic tank has an effluent filter (Yes). Effluent filters require periodic cleaning. Failure to clean the filter could result in a backup of sewage into the building or effluent breakout. Restaurants serviced by external grease interceptor tank(s) require quarterly inspections and cleaning as necessary. Tank pump-outs are not tracked by Greenwich Health Department.


Construction Permit No.: PRHD202200310
Parcel Tax ID No.: 11-2058
Date of Final Inspection: 03/30/2023
Installation Inspected By: Claire Durkota
Date of Issuance: 04/21/2023

Approved As-Built on File: Yes

IN ACCORDANCE WITH Exhibit(s): F1, F2.

And All Other State and Local Requirements, rules and regulations pursuant thereto.

Provisions: (1) That no nuisance or condition detrimental to health shall be created or maintained (2) that additions and alterations to and/or changes in the use or operation of these facilities shall be made when in the opinion of the Director of Health such are deemed necessary and (3) the septic tank shall be inspected regularly and cleaned not less than once every three years.

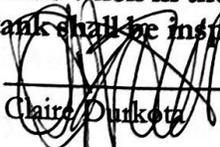

Claire Durkota

Division of Environmental Services

SPECIAL REQUIREMENTS OR RESTRICTIONS:

1. Wastewater from water treatment systems cannot discharge to the subsurface sewage disposal system.
2. Signs of system malfunction or failure should be addressed.


EXCEPTIONS (Repairs Only):



ELEVATIONS:
 EX. SEWER LINE: 87.75.
 SEPTIC TANK INLET: 87.00
 OUTLET: 86.75
 PUMP CHAMBER INLET: 86.50
 2" PVC OUTLET: 86.25
 D-BOX INLET: 93.66
 LATERAL: 93.50
 BOTTOM SYSTEM: 91.50

A-1 = 21' B-1 = 28'6"
 A-2 = 29' B-2 = 29'
 A-3 = 38' B-3 = 30'
 B-CO = 12'

C-S = 39'6" D-S = 30'
 C-L = 71' D-L = 51'6"

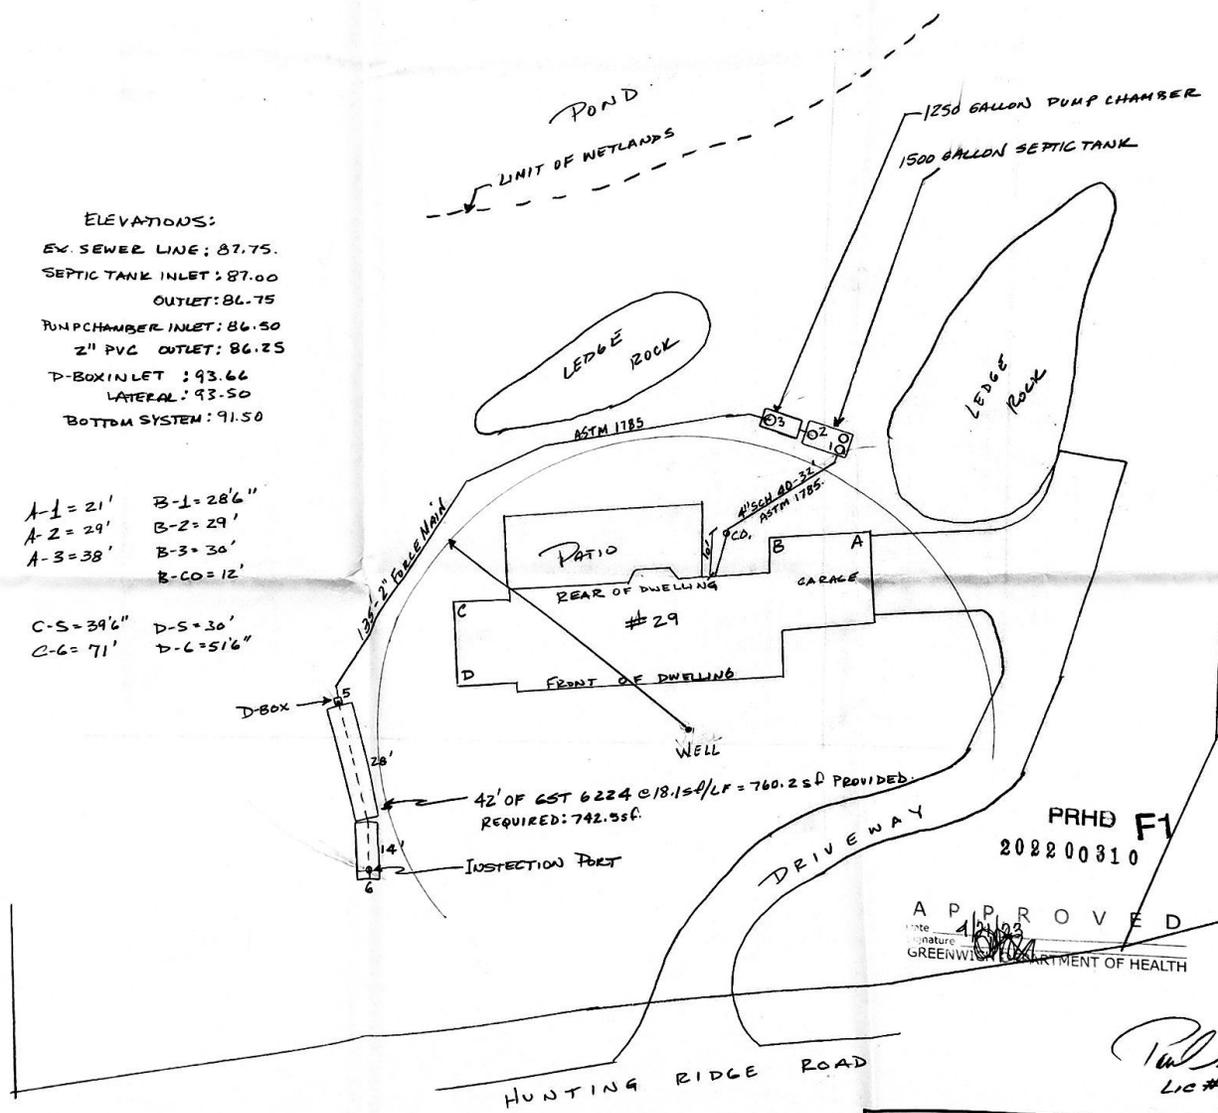

42' OF CST 6224 @ 18.150/LF = 760.250 PROVIDED.
 REQUIRED: 742.950.

PRHD F1
 202200310

APPROVED
 Date: 1/2/23
 Signature: [Signature]
 GREENWICH DEPARTMENT OF HEALTH

[Signature]
 LIC #5075

NOTE: FOR ADDITIONAL DATA, REFER TO THE PROPOSAL DRAWING
 APPROVED BY THE DEPARTMENT OF HEALTH, TOWN OF GREENWICH.

| | | | |
|--|--------------|----------------|------------------------|
| AS-BUILT OF 6 BEDROOM SYSTEM | | | |
| SCALE: 1"=20' | APPROVED BY: | DRAWN BY: P.S. | |
| DATE: 4-16-23 | | REVISED | |
| FOR: HENRY KIM 29 HUNTING RIDGE RD. | | | |
| BY: LAUREL HILL INC. 34 NOB HILL LN., STAMFORD. | | | |
| | | | DRAWING NUMBER 4163 |