


CDD COVER SHEET FOR JMM
04/19/2005 15:33:01

EH
2 PAGES

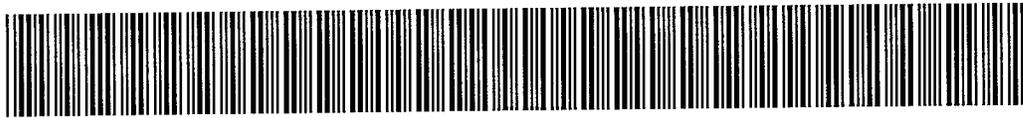

FILE ID	1711110000200EH20050419153301
TAXMAP	1711110000200
SERIAL	112878
DIVISION	EH
SITUS	63950 TYLER RD
HOUSE#	63950
STREET	TYLER
CONTENT	AS BUILT S53257
RECORD ID	S53257

SEPTIC INSPECTION REQUEST AND NOTICE (AS-BUILT FORM)

Date Received _____

THIS FORM MUST BE RECEIVED & APPROVED PRIOR TO PRECOVER INSPECTION!

SEPTIC PERMIT # 553257


INSTALLER'S PHONE NUMBER 410-9133

JOB SITE ADDRESS 63950 TYLER RD. BEND OR.

Deschutes County has 7 days to inspect the completed construction after this form has been officially received and deemed approvable. Complete this form with ALL of the following information for consideration of approvability

Use This Space for the As-Built Drawing: DRAWING MUST BE ON THIS FORM
(Drawing does not need to be scaled but does need to be proportional)

This system construction drawing is to be detailed and accurate and is to include septic tank(s) & absorption facility (footages required) with all associated solid header piping, distribution box, drop boxes, distributing valves, & inspection ports; North arrow; distances from tank and absorption facility to all buildings served by this system, and distances to other nearby encumbrances (wells, property lines & outbuildings within 50' of system components, driveways, surface waters); and the future replacement:(reserve) area.

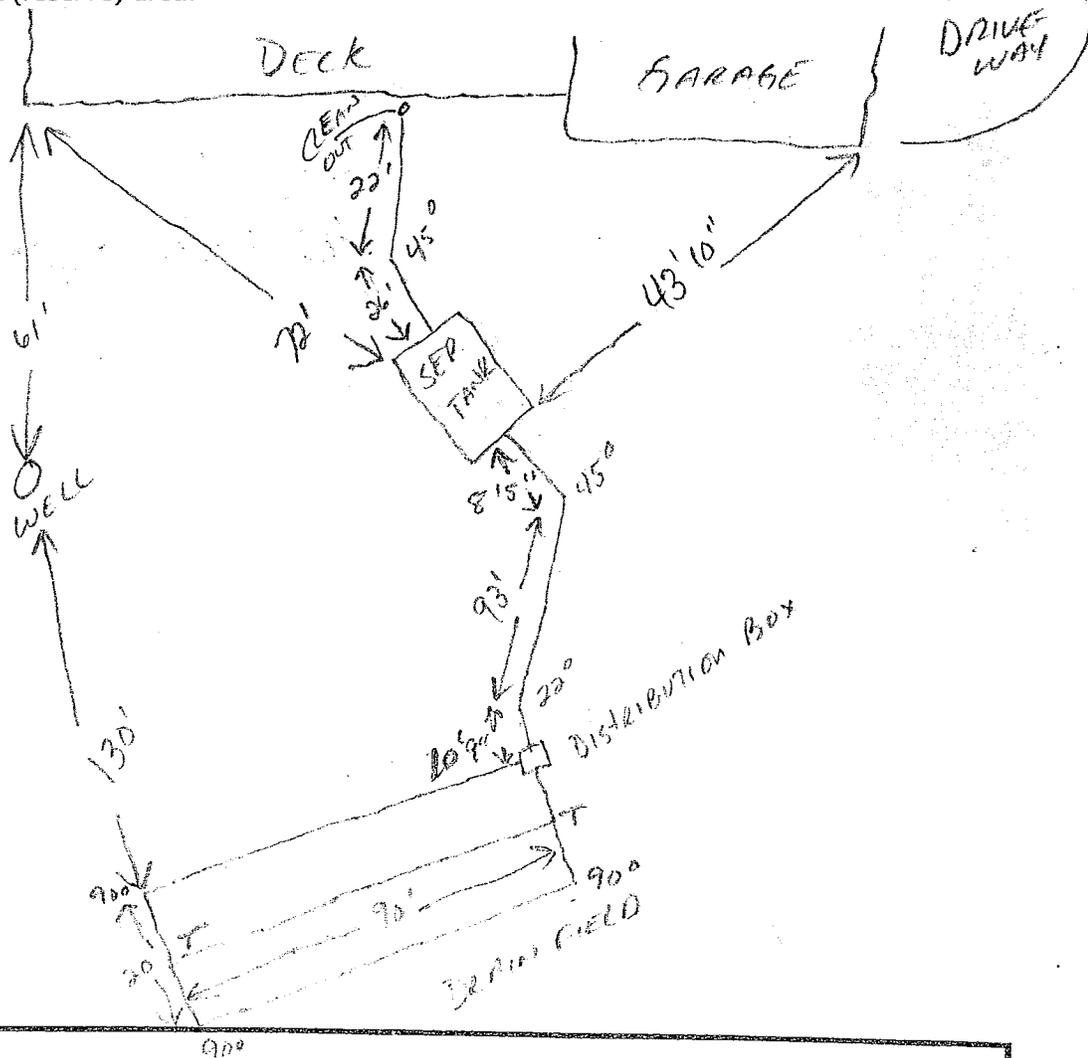

Construction was performed by:

Property owner (Permittee)

Licensed D.E.Q. Installer Business Name: Aspen Creek

LICENSE # 37816

I certify the information provided in this notice is correct, and that the construction of this system was in accordance with the permit and rules regulating the construction of on-site sewage disposal systems (OAR Chapter 340, Divisions 71 and 73).

INSTALLER'S SIGNATURE: [Signature]

SEPTIC PERMIT # 553257

On-Site System Components List

Please list all materials used in constructing this system in the spaces provided below **OR SUBMIT INVOICES, PURCHASE RECEIPTS, ETC (STRIKE ANY MATERIALS ON THESE INVOICES & RECEIPTS NOT USED SPECIFICALLY FOR THIS CONSTRUCTION—VERIFY QUANTITIES USED FOR THIS JOB).**

Component	Quantity/Length	Size – Supplier – Manufacturer - Model Number
Septic Tank(s)/ Dosing Septic Tank(s)	1000 gal.	ADVANCED PRECAST
Gravity Effluent Sewer Piping	300 FT	4" WHITE SEWER PIPE
DEQ Drain Rock	30 yds	SA MOORE
Drop Boxes		
Distribution Box	1	Tuff tite
Filter Fabric	300 FT	3' WIDE FABRIC
Effluent Filter		
Distributing Valve		
Infiltrator Chambers		
Infiltrator Wire Mesh		
Capping Fill Material		
Pump Package		
Pump Transport Piping		
Pressurized Drainline Piping		
Pump Control Box		
DEQ Pea Gravel		
DEQ Sand Filter Media		
Dosing Timer		
PERNCO Couplers	2	2-4" / 4"-3"
Other: 22" 1/2	1	PVC 22"
30" 3/4 Sewer Pipe	160' 2"	KILKEN PRESSURE SEWER PIPE
90° Elbows	3	PVC 90°
Tees	2	PVC TEES
45° Elbows	2	(1) PRESSURE 45 (1) PVC