

Final/AS-BUILT--Subsurface Sewage Disposal



Public Health
Prevent. Promote. Protect.

Idaho Public Health Districts

Central District Health Department


707 N. Armstrong Place
Boise, ID 83704
(208) 327-7499

Parcel ID# 160791

Applicant's Name: Pat Boomer & Derk Brill
Property Address: 1217 E 10 Rd
McCall, ID

Phone # 650 962 1895

Legal Description: 1/4 NE 1/4 SE Section: 22 Township: 18N Range: 03E
Subdivision: 0 Lot: _____ Block: _____ Size(acres): _____

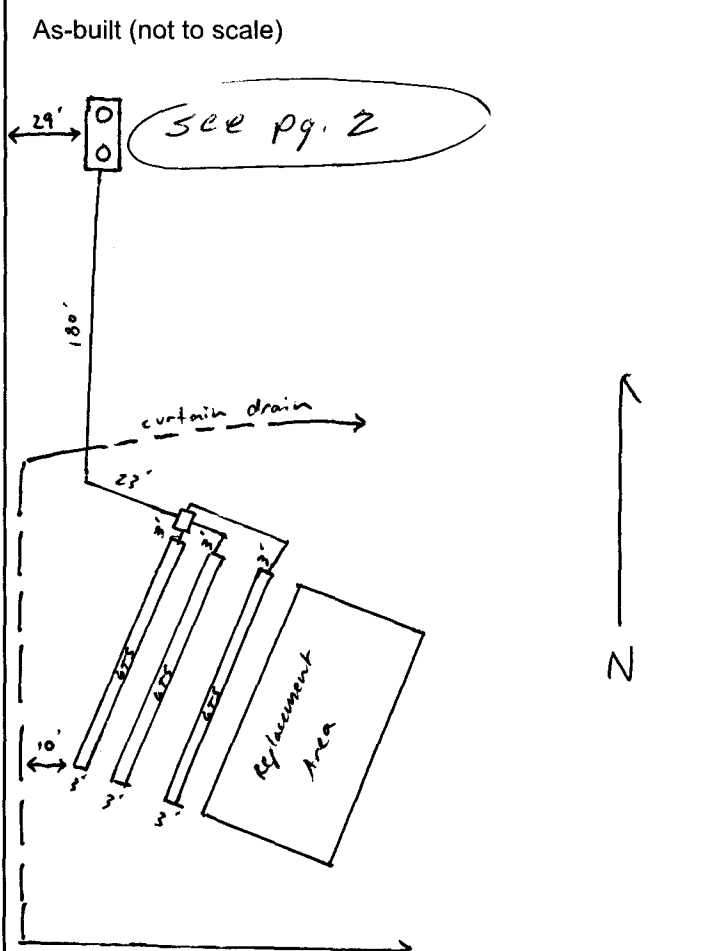

System Type:	Gravel (yards):
<u>Cap Fill</u>	<u>GDS</u>
System Mfg:	Sand (yards):
<u>AH</u>	<u>NA</u>
Septic/Trash Tank (Gal):	Depth to Pipe (inches):
<u>1000</u>	<u>+ 4"</u>
Septic/Trash Tank Mfr:	Rock Under Pipe (inches):
<u>LAR-Ken</u>	<u>GDS</u>
Depth to Tank Lid (inches):	Date System Installed:
<u>8"</u>	<u>10/18/13</u>
Standpipe/Riser (inches)	Riser Longitude:
<u>NA</u>	<u>NA</u>
Pump Tank:	Riser Latitude:
<u>NA</u>	<u>NA</u>
Pump Tank Mfg:	Well Installed
<u>NA</u>	<input type="checkbox"/> Yes <input checked="" type="checkbox"/> No
Drainfield Width (Ft):	Distance to Tank (Ft):
<u>3</u>	<u>NA</u>
Drainfield Length (Ft):	Distance to Drainfield (Ft):
<u>255</u>	<u>NA</u>
Drainfield Area (Sq Ft)	Valve: <input type="checkbox"/> Yes <input type="checkbox"/> No
<u>765</u>	D-Box: <input checked="" type="checkbox"/> Yes <input type="checkbox"/> No

All plans, specifications, and conditions contained in the approved permit application are hereby incorporated into And may be enforceable as part of the permit.

Notes/Conditions of Approval: _____

GPS Readings: Tank: N _____ W _____ Well: N NO WELL W _____

Installer Name: Randy Morell
Installer Number: 1302

Signature: Randy Morell
Date: Nov 21 2013

By signing above, I certify that all answers and statements on this Final/As-Built are true and complete to the best of my knowledge.
Official Use Only

- As-Built provided by EHS
- As-Built provided by Installer

EXHIBIT A

EHS Final Inspection Signature
EHS Code 007 Date 11/21/13 8/10 NRU

PAT BOOMER & DERK BRILL
New Residence, Valley County, ID

