


2888

19C(1) 14

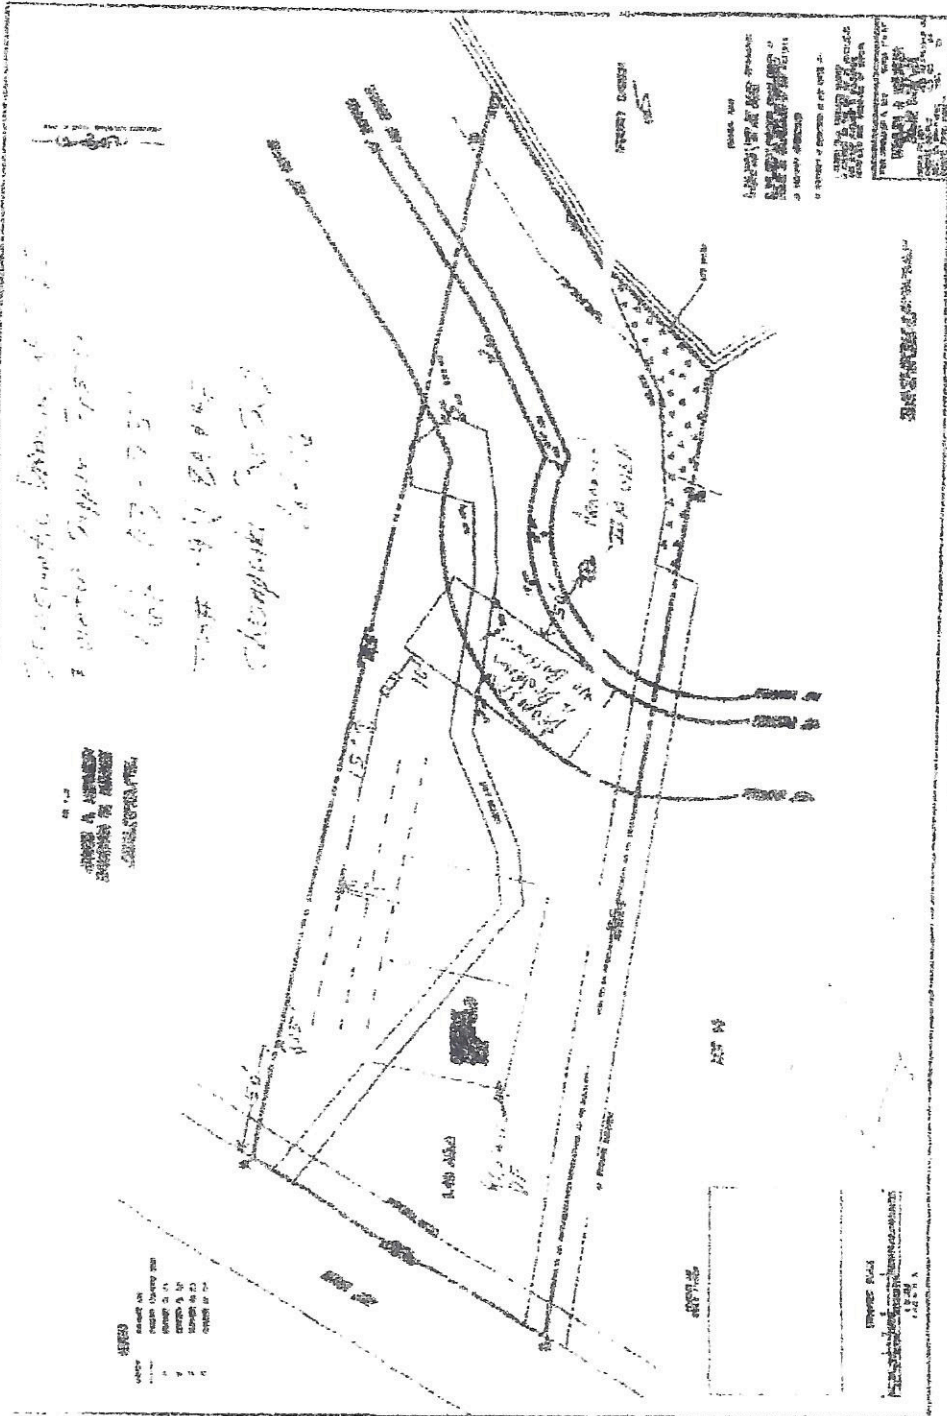

Line 700-2

Precinct 6
 7 water supply 7500
 166-03-751
 19C(1) 8A & 42
 Chempinski 10/10

As built
 5-60' EZ Flow
 lines

Owner: James & Barbara Kennedy
 HDID: 166-03-751
 Tax map: 19(1) 8A & 42