

IREDELL COUNTY HEALTH DEPARTMENT

STATESVILLE 704-878-5305

MOORESVILLE 704-664-5281

IMPROVEMENT PERMIT / AUTHORIZATION TO CONSTRUCT / OPERATION PERMIT / EXISTING SYSTEM INSPECTION


PERMIT# 80212 PIN# 469966644 A 41649664469 DATE 4/15/99
 OWNER OR CONTRACTOR PIEDMONT HOUSING PHONE: Business _____ Home 528-7120
 ADDRESS 1040 CHARLOTTE HWY - TRAUTMAN NC 28166
 LOCATION 115 N - 7L FLOWERHOUSE - TL RANWEN HELL - TR GAULE ON LT
 SUBDIVISION WESTWINDS BLOCK / SECTION 2 LOT 38 LOT AREA 61AC SITE CLASS. RS DESIGN FLOW 3600GPD L.T.A.R. 3000/FT²

Septic Tank: <u>1000</u> Gallons: STB <u>1812</u> Date <u>3/19/98</u>	<input checked="" type="checkbox"/> New System <input type="checkbox"/> Repair System Type: I, II, III, IV, V, VI	<input checked="" type="checkbox"/> House/Mod. Home No. Bedrooms <u>3</u>	Water Supply: <input checked="" type="checkbox"/> Individual <input type="checkbox"/> Public <input type="checkbox"/> Community
Pump Tank: _____ Gallons: PT _____ Date _____	System Description: <u>GRAVITY FEED</u>	<input type="checkbox"/> Mobile Home No. Bathrooms <u>2</u>	
Pump Make: _____ Model _____ Serial No. _____	Repair System Description: <u>SAME</u>	<input type="checkbox"/> Business No. Employees _____	
Nitrification Field: No Fields <u>1</u> Square Feet <u>900</u> Linear Feet <u>300</u>	Maintenance Agreement Required: <input type="checkbox"/> Yes <input checked="" type="checkbox"/> No	<input type="checkbox"/> Other _____	
No Lines <u>4075'</u> Trench Width <u>36"</u> Max Trench Bottom Depth <u>36"</u> Gravel Depth <u>NA</u>	<input type="checkbox"/> Slab <input checked="" type="checkbox"/> Crawl Space <input type="checkbox"/> Basement w/plumbing <input type="checkbox"/> Basement wo/plumbing		


Comments/Conditions:

Comments/Conditions:

INITIAL SITE SKETCH

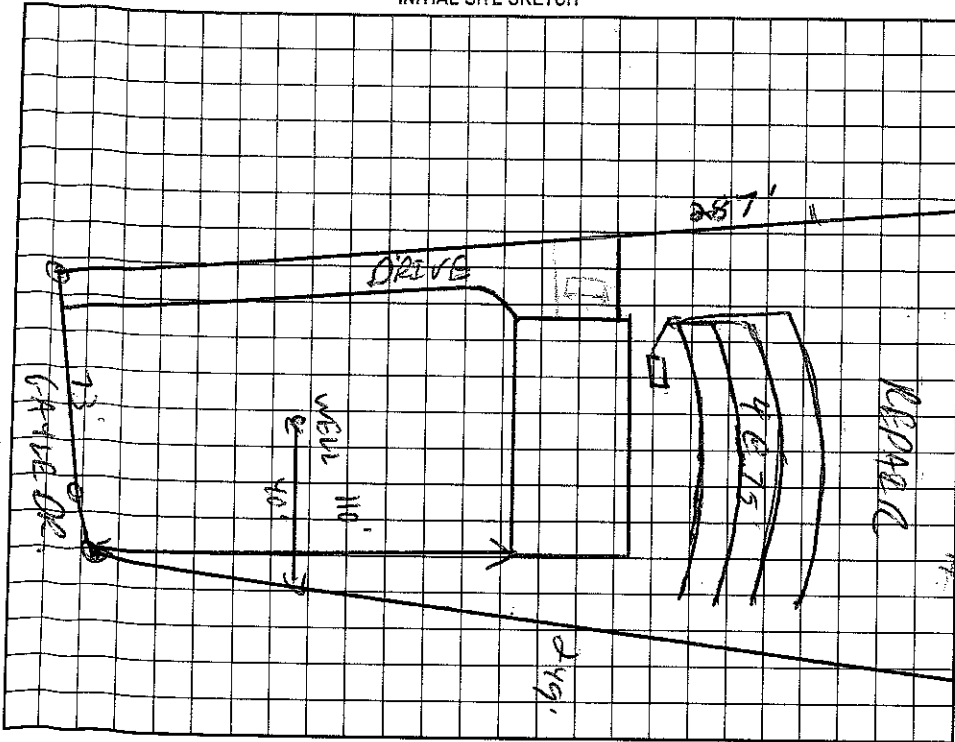

AS BUILT SKETCH

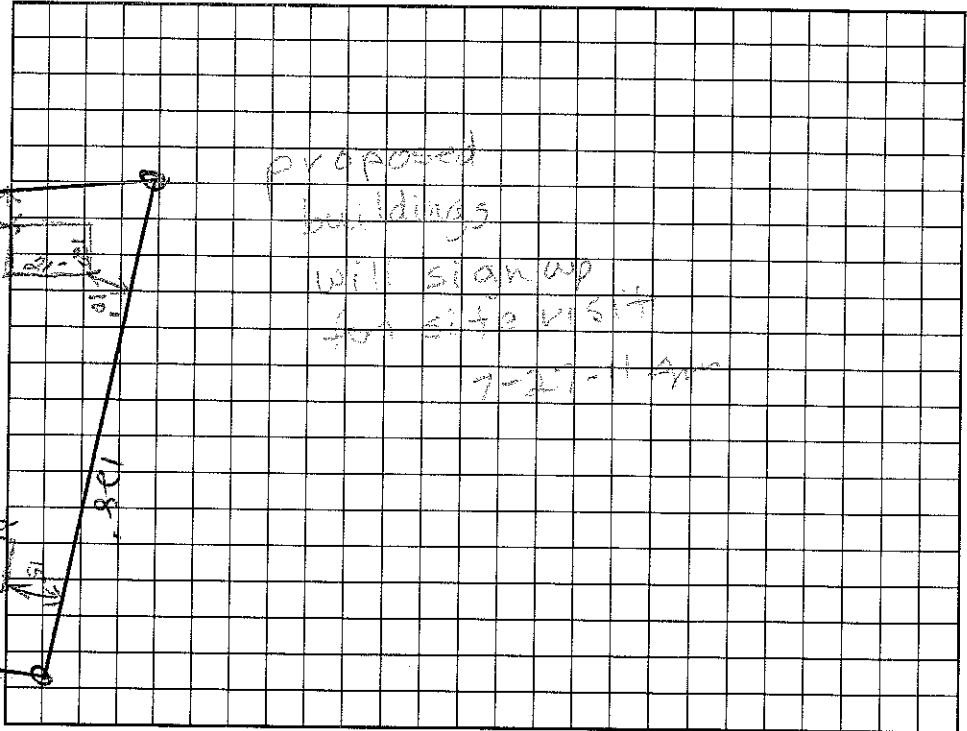

Permit can be suspended or revoked if any false information is supplied toward securing the permit/any unauthorized changes are made to the site/any unauthorized changes are made in the installation of the system. Improvement Permit with plat valid without expiration. Improvement Permit with site plan valid for sixty months. Authorization to Construct is valid for a period equal to that of Improvement Permit - not to exceed sixty months.

Signed: [Signature] date 4-26-99 Installed by: AL BACKHOFF
 Improvement Permit by: C. Byrd RS date 4/15/99 Operation Permit by: C. Byrd date 5/7/99
 Authorization to Construct by: C. Byrd RS date 4/15/99 Existing System Inspection by: _____ date _____

HEALTH DEPT. COPY: WHITE

OWNER COPY (FINAL): YELLOW

OWNER COPY (INITIAL): PINK