

SEPTIC PRECOVER INSPECTION REQUEST AND NOTICE FORM (AS-BUILT FORM)

All septic system inspections are to be requested through the county's Interactive Voice Recording (IVR) system at 317-3174. Deschutes County then has seven days to complete the inspection. Complete and submit this form to a Deschutes County Community Development Department (CDD) office prior to the precover inspection. Incomplete or inaccurate forms will not be approvable. Use the space below for the As-Built drawing and complete the Materials Listing section and Installer Info section on backside of this form. This form can be faxed or mailed to a CDD office:

Bend: 117 NW Lafayette Ave Bend, OR 97701

Fax # 385-1764

Redmond: 657 SW Glacier Ave Redmond, OR 97756

Fax # 923-3097

La Pine: 51340 S. Hwy 97 P.O. Box 3464 La Pine, OR 97739

Fax # 536-5851


SEPTIC PERMIT # S-247-18-000841 INSTALLER PHONE # 541-480-7363

PERMIT JOB ADDRESS 17740 OX Spur C.T.

(OFFICE USE ONLY: Date Form Received _____)

AS-BUILT DRAWING

{Show at LEAST the following: North arrow, all system major components (see back side of this form for major components), proposed & existing adjacent structures/driveways/utility lines, future replacement area(s) as shown on approved plot plan, and lengths of drainlines & effluent transport sewers. Show distances between system components and to wells, structures/driveways/utility lines, and nearest property lines & bodies of waters— if within 150' of initial and reserve system areas. Note existing septic system components such as tanks, drainfields, etc as "existing".}

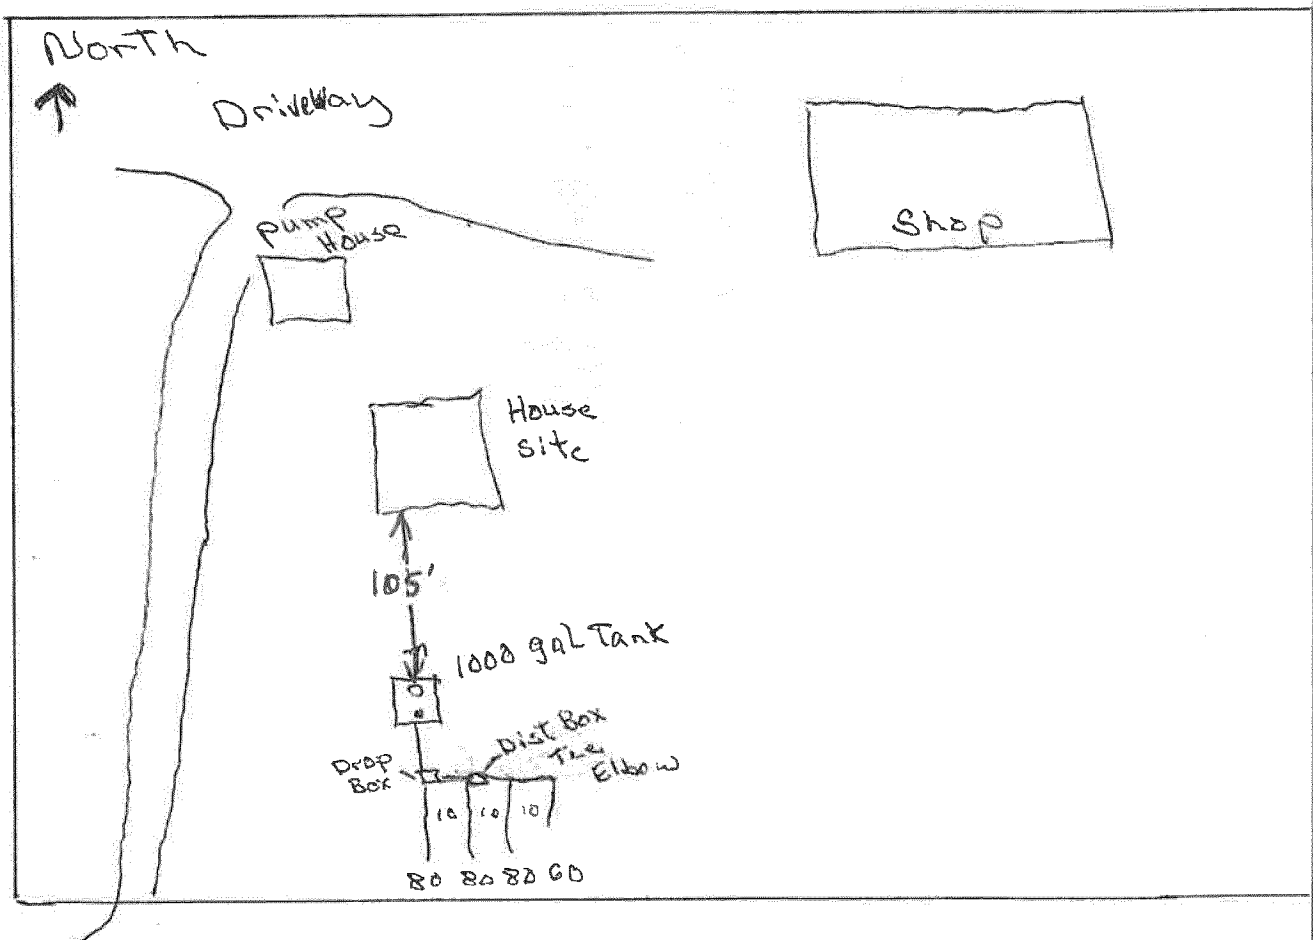

247-18-000841

Septic Permit # 5- Construction By: (Check One) _____ Property owner (Permittee) or ☒ Licensed D.E.Q. Installer

{ DEQ INSTALLERS COMPLETE THIS SECTION: Business Name: _____

DEQ LICENSE # 37276

DEQ CERTIFICATION # of SIGNEE RI 212 }

I certify the information provided in this notice is correct, and that the construction of this system was in accordance with the permit and rules regulating the construction of on-site sewage disposal systems (OAR Chapter 340, Divisions 71 and 73).

NAME: Roger Abbas

PRINT

SIGNATURE

9-8-18

DATE SIGNED

MATERIALS LISTING SECTION: List only products installed for this job

MAJOR COMPONENT	TOTALS	PRODUCT SPECIFICATION INFORMATION
Septic Tank	1,000 Gallons	Manufacturer <u>Advanced precast</u>
Dosing Septic Tank	Gallons	Manufacturer _____
(Two Compartment)	Gallons	Check: _____ Flow-Thru or _____ Baffled (up & over sanitary tee)
Dosing Tank	# of: _____	Manufacturer _____
Effluent Filter	# of Each: _____	Manufacturer/Model # _____
Pumps:		Pump Manufacturer _____
Pump Packages		Supplier _____
Dosing Timer		Pump Model Numbers _____
Control Box		Timer Manufacturer & Model # _____
Swing Check Valve		Box Manufacturer & Model # _____
Anti-Siphon Valve		Valves Manufacturer & Model #s _____
ATT Unit:	# of Each: _____	Manufacturers _____
Advantex		Make/Model #s _____
Multi-Flt		Suppliers _____
Whitewater		
Puraflo		
MicroFast		
Effluent Sewer Pipe	2 Ft.	Pipe Supplier <u>HD Fowler</u>
(Gravity or Pressurized)	2 Ft.	Pipe Diameter <u>4</u> (Inches) ASTM # on Pipe <u>3034</u>
Tracer Wire	# of: _____	Valve Manufacturer & Model # _____
(Min. 18 gauge, Green)	# of: _____	
Switching Valve		
Spring Check Valve		
Sandfilter Container:		Container Sidewall Material: Check One
Dimensions	_____ Ft x _____ Ft	_____ 3/4" Plywood _____ Designed by Prof. Engineer
Filter Fabric	_____ Sq. Ft.	_____ 3/4" OSB (all edges sealed)
Liner	Size: _____	Fabric Manufacturer _____ Type _____
DEQ Pea Gravel	_____ Yds.	Liner Manufacturer & Model # _____
DEQ Sand Media	_____ Yds.	Pea Gravel Supplier _____
Pressurized Laterals	_____ Ft.	Sand Media Supplier _____
Orifice Spacing	_____ Ft.	Pipe Supplier _____
Junction Boxes & Piping:		Pipe Diameter _____ (Inches) ASTM # on Pipe _____
Drop Boxes	# of: <u>1</u>	Manufacturer & Supplier <u>HD Fowler</u>
Distribution Boxes	# of: <u>1</u>	Check: _____ Concrete or ☒ Poly
Overflow & Header Piping	_____ Ft.	ASTM # on Pipe _____ Pipe Diameter _____ (Inches)
Drain Media: <u>Drain Rock</u>	_____ Yds.	Rock Supplier _____
Perf Pipe	_____ Ft.	Pipe Supplier _____
Filter Fabric	_____ Ft.	Pipe Diameter _____ (Inches)
Drain Media: <u>Chambers</u>	# of chambers _____	ASTM # on Pipe _____
Infiltrator (4' chambers)	_____ Ft.	Fabric Manufacturer _____ Type _____
Infiltrator (8' 4" chambers)	_____ Ft.	Chamber Supplier _____
HanCor Arc 18 (5' chambers)	_____ Ft.	
BioDifuser (7' 2" chambers)	_____ Ft.	
Wire Mesh	_____ Ft.	Mesh Supplier _____
Drain Media: <u>Cylinders</u>		EZ Flow Supplier <u>HD Fowler</u>
EZ Flow	300' Ft.	Check one of the following:
Filter Fabric	_____ Ft.	☒ Model 1201P (Single cylinder installation in each drainline)
(If not already "stitched" onto cylinders by manufacturer)		_____ Model 1202P (2 side by side cylinders installation in each drainline)
Pressurized Drainfields:		Fabric Manufacturer _____ Type _____
Drainline Piping	_____ Ft.	Pipe Supplier _____
Capping Fill Drainfield Mt'l	_____ Yds.	Pipe Diameter _____ (Inches) ASTM # on Pipe _____
		Supplier: _____