



Lancaster County Health Department
PO BOX 158
Lancaster, Virginia 22503
(804) 462-9919 Voice
462-6211 Fax

Sewage Disposal System Operation Permit

Property Owner

Charles Lockhart
736
Irvington, VA 22480
Phone: (804)

Health Dept. ID: **151-15-0092**
Tax Map/GPIN: **33-245**
Locality: **Lancaster County**

Property Location

Property Address: 792 King Carter Drive
Irvington, VA 22480

Directions: Route 3 to Kilmarnock, R/T 200 Irvington Road, R/T King Carter Drive turn left just past Whays Way on right.

Charles Lockhart is hereby granted permission to operate a **TYPE 2 ALTERNATIVE RESIDENTIAL MicroFAST ATU and AGGREGATE PAD ONSITE SEWAGE DISPOSAL SYSTEM** at the above referenced location, under the following parameters:

Daily Flow: 600 gallons

Number of Bedrooms: 4

WATER is supplied by an **APPROVED PUBLIC WATER SYSTEM (Irvington)**

This permit is issued in accordance with the provisions of Title 32.1, Chapter 6 of the Code of Virginia as Amended, and Section 12VAC 5-610-340 of the Sewage Handling and Disposal Regulations of the Virginia Department of Health. The issuance of an operation permit does not denote or imply any guarantee by the department that the sewage disposal system will function for any specified period of time. It shall be the responsibility of the owner or any subsequent owner to maintain, repair, or replace any sewage disposal system that ceases to operate in accordance with the regulations.

The continued validity of this permit is contingent upon compliance with the operation and maintenance requirements contained in the Owner's Operation and Maintenance Manual and Regulations for Alternative Onsite Sewage Systems of the Virginia Department of Health (12VAC5-613-100 et seq.). Owners are advised to be aware of the operation and maintenance instructions for their alternative onsite sewage system and to follow them. Copies of the operation and maintenance instructions can be found by contacting the local health department for the locality where the onsite sewage disposal system is located.

December 09, 2015
Effective Date

Timothy Childs
Environmental Health Specialist, Sr.


Signature

Completion Statement

Commonwealth of Virginia
State Department of Health

Health Department
Identification Number:

151-15-0092

Lancaster County, Health Department

Name of Company/Corporation/Individual:

Thomas W. Beasley Septic Contractor

Address:

5964 Historyland Hwy. Farmham, Va. 22460 Telephone: 804-394-9658

Owner's Name:

Charles Lockhart

Owner's Address:

P.O. Box 736 Irvington, Va. 22480

Location of Installation: Lot

Block:

Section:

Subdivision:

Other:

Tax map # 33-245

(Date)

8/28/15


Specifications for the project.

I hereby certify that the onsite sewage disposal system has been installed and completed in accordance with the construction permit issued and is in compliance with Part D of the Sewage Handling and Disposal Regulations and when appropriate the plans and

Date

11/12/15

Signature and Title

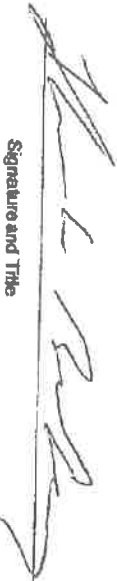

AOSE/PE Inspection Report and Completion Station

Commonwealth of Virginia
State Department of Health

Health Department Identification Number: 151-15-0092

Tax Map: 33-245

Lancaster Health Department

Name of AOSE/PE: David R. Miles

Certification Number: 1111

Address: Soil Evaluation Services, P. O. Box 140, Topping, Virginia 23169

Telephone: (804) 758-3511

Contractor's Name: Beasley Septic

Owner's Name: Charles G. Lockhart


Owner's Address: P.O. Box 736 Irvington, VA 22480


Location of Installation: Subdivision: Section: Block: Lot:

Other:

Inspection Results

Component	Comments, Material, Etc. Deficiencies Observed, Date Deficiencies Observed Corrective Action Required	Date Approved
Water Supply Location and Construction	Public	
Building Sewer	Approved. See As built for clean-out locations.	11/11/15
Septic Tank	Hanover, two compartment MicroFAST tank.	11/11/15
Inlet-Outlet Structure	Approved.	11/11/15
Pump and Pump Station	N/A	
Conveyance Method	Approved.	
Distribution Box or Pressure Manifold	8 hole, concrete box. Approved.	11/11/15
Header, Conveyance, Return, etc. Lines	Approved.	11/11/15
Percolation Lines, Drip, Chambers, etc.	Low profile, ARC 36 chambers installed on sand. Approved.	11/11/15
Absorption Trenches and Dispersal Field	Approved.	11/11/15
(Other Components: treatment unit, etc.)		

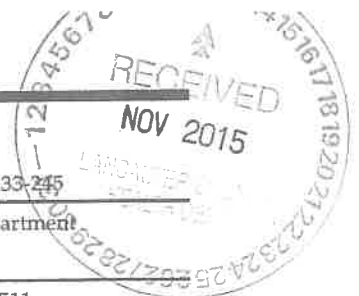

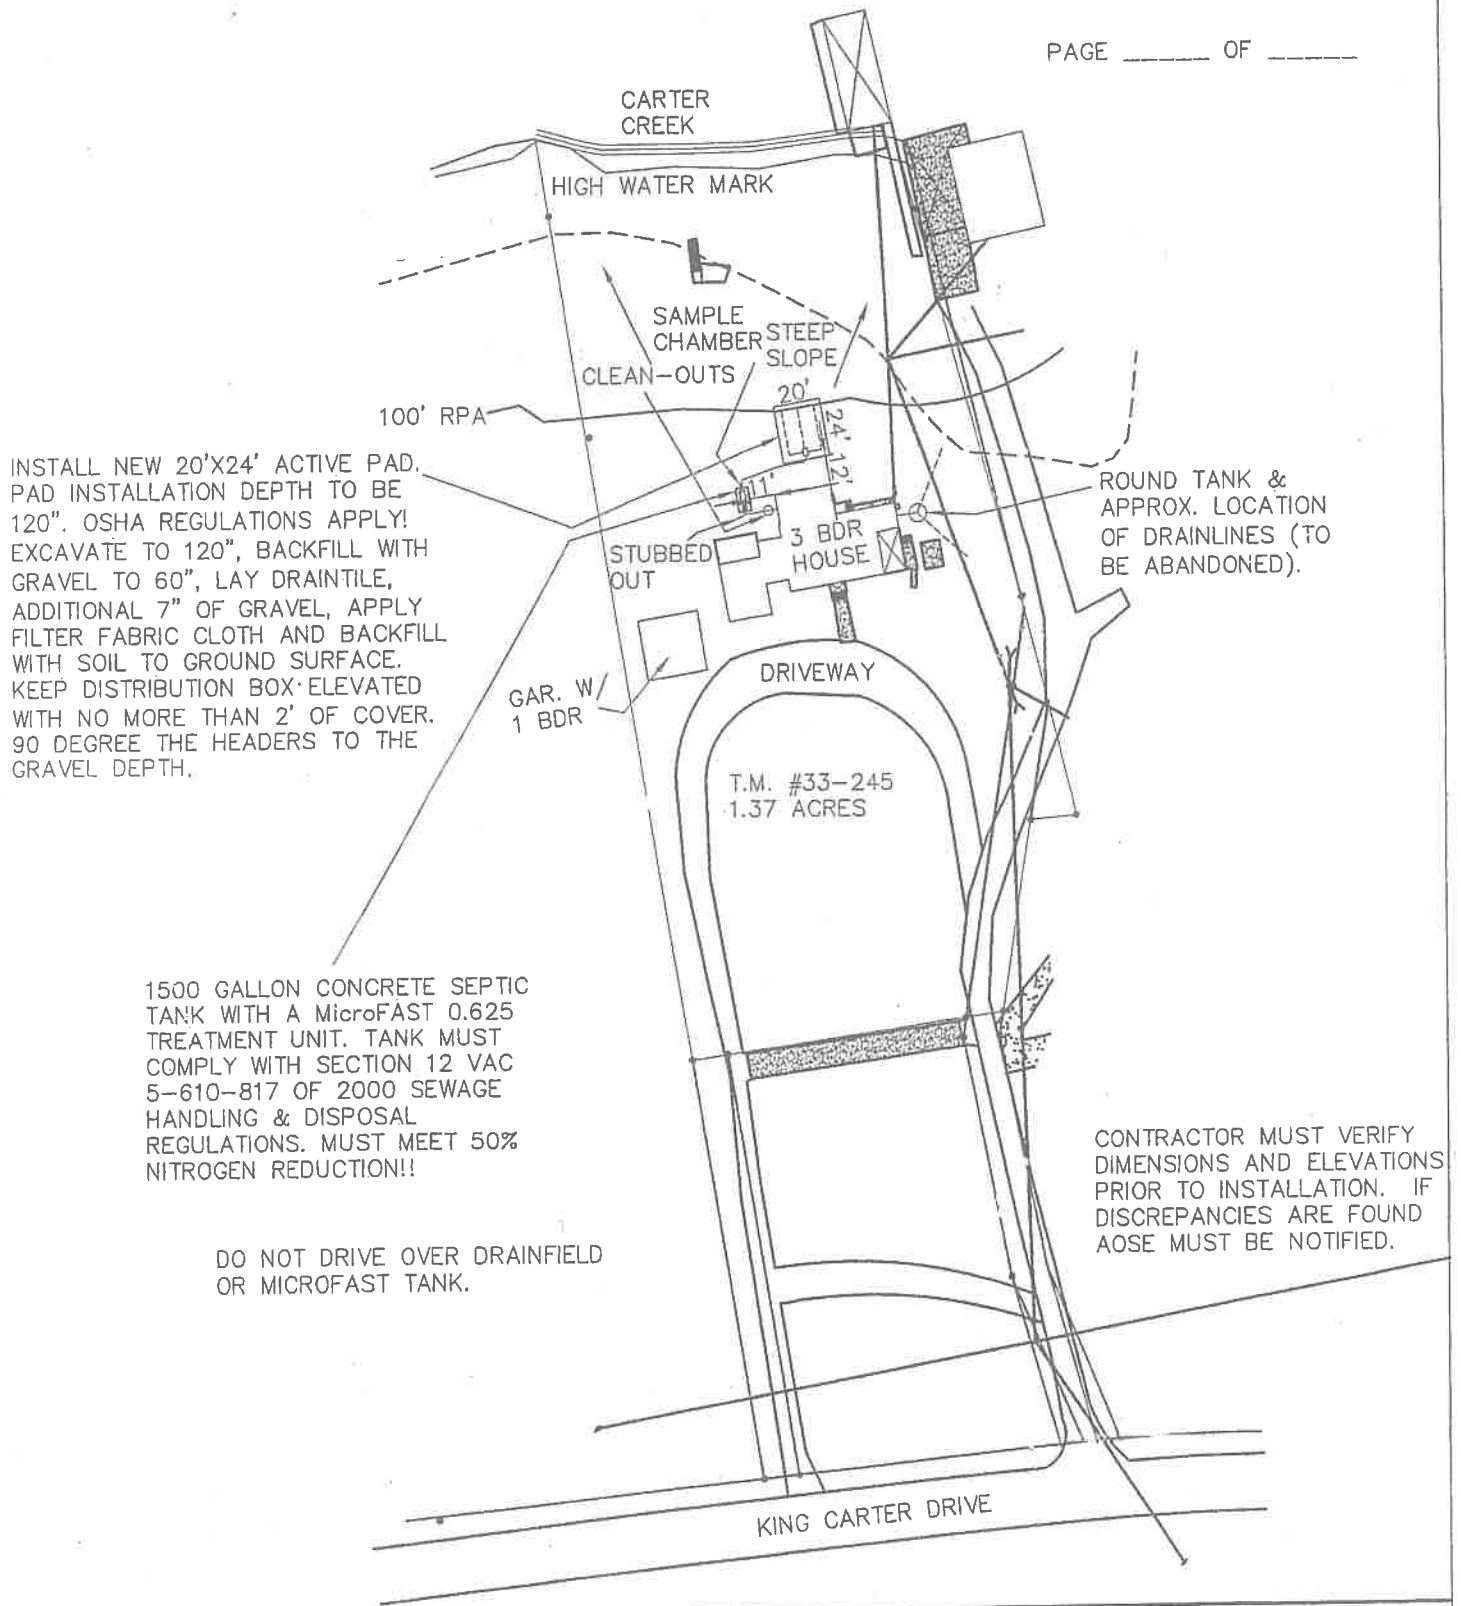

CONTRACTOR IS RESPONSIBLE FOR STABILIZATION (GRADING & SEEDING) UPON COMPLETION OF INSTALLATION TO PROMOTE DRAINAGE AWAY FROM SITE.

Title		As Built!!	
Reference Subtitle		Charles G. Lockhart, T.M. #33-245 Lancaster County, VA	
Drawn By	DRM	Approved By	DRM
Date	11/11/2015	Scale	1" = 80'
Revision	0	Drawing No.	