

REFERENCE PLANS:

1. "AS-BUILT PLAN (LOT 2/98-1) - BUCKMEADOW - CONDOMINIUMS-VETERANS ROAD-AMHERST, NEW HAMPSHIRE - PREPARED FOR - BUCKMEADOW REALTY TRUST - 3 UPLAND ROAD - LITTLETON, MASSACHUSETTS 01480" - SCALE: 1"=100' DATED JAN. 16, 1980, REV. THRU 6/30/87 BY A.H.SWANSON, INC. H.C.R.D. PLAN NUMBER 25327.

2. "SITE LAYOUT AND SUBDIVISION PLAN-BUCKMEADOW-CONDOMINIUMS-MILFORD ROAD-AMHERST, NEW HAMPSHIRE" SCALE: 1"=100' DATED JAN. 16, 1980 BY A.H.SWANSON, INC. H.C.R.D. PLAN NUMBER 19057.

3. "BOUNDARY,SUBDIVISION AND CONSOLIDATION PLAN-MILFORD ROAD-AMHERST, NEW HAMPSHIRE - PREPARED FOR - M.E.YOUNG, INC." SCALE: 1"=100' DATED MARCH 31, 1981, REV. THRU 4/2/81 BY A.H.SWANSON, INC. H.C.R.D. PLAN NUMBER 13989.

2-121-1

2-124

2-98-33


NOTES:

1. THE PURPOSE OF THIS PLAN IS TO DEPICT THE SITE PLAN REQUIREMENTS OF RSA 356-B:20 I & V FOR BUILDINGS 'E' & 'G' OF PHASE III.
2. PHASE III IS SERVICED BY MUNICIPAL WATER WITH ONSITE SEWERAGE DISPOSAL SYSTEMS.
3. SEE REFERENCE PLAN ONE FOR ADDITIONAL NOTES.

CERTIFICATION:

I CERTIFY THAT THIS SURVEY PLAT IS NOT A SUBDIVISION PURSUANT TO THIS TITLE AND THAT THE LINES OF STREETS AND WAYS SHOWN ARE THOSE OF PUBLIC OR PRIVATE STREETS OR WAYS ALREADY ESTABLISHED AND THAT NO NEW WAYS ARE SHOWN (RSA 676:18 1/1/96).


DATE: 4-24-98

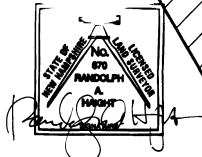

CERTIFICATION:

"I HEREBY CERTIFY THAT THIS PLAN FULLY AND ACCURATELY DEPICTS THE LOCATION AND DIMENSIONS OF THE LAND AND EXISTING IMPROVEMENTS OF PHASE III SHOWN THEREON AND, TO THE EXTENT FEASIBLE, ALL EASEMENTS APPURTENANT THERETO, THAT UNITS 22-25 & 30-32 DEPICTED THEREON AS COMPLETE HAVE BEEN SUBSTANTIALLY COMPLETED AND THAT THIS PLAN COMPLES WITH THE PROVISIONS OF RSA 356-B:20 I & V"

GRAPHIC SCALE

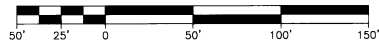

2-98

17.894 ACRES
779,489 SQ.FT.

2-97

AS-BUILT SITE PLAN - PHASE III BUILDINGS 'E' and 'G' BUCKMEADOW CONDOMINIUMS AMHERST, NEW HAMPSHIRE

PREPARED FOR
CLARK CHAIN PROPERTIES L.L.C.
P.O. BOX 581 - NASHUA, N.H. 03061

SCALE: 1" = 50'

APRIL 9, 1998



MERIDIAN
Land Services, Inc.

STREET ADDRESS: 31 OLD NASHUA RD. SUITE 2, AMHERST, N.H. 03031 TEL 603-673-1441 FAX 603-673-1584
MAILING ADDRESS: PO BOX 118, MILFORD, N.H. 03055-0118 EMAIL: MERIDIANLS@aol.com
636 DANIEL WEBSTER HWY. PO BOX 536, MERRIMACK, N.H. 03054 TEL 603-424-1000 FAX 603-424-4340

ENGINEERS - LAND SURVEYORS - SCIENTISTS - LAND PLANNERS


FILE NO. 215101 PROJECT NO. 2159.00 SHEET NO. 1 OF 1

BUCK-
MEADOW
CONDO

PL 29143
1 of 2
Folder


98 APR 27 AM 8:58

827513

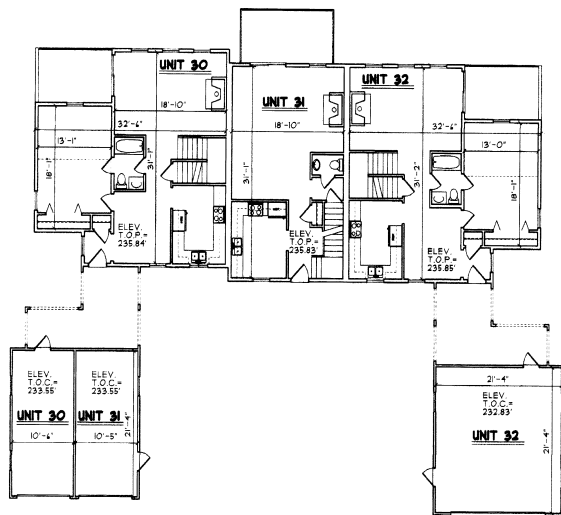


FIRST FLOOR PLAN

SCALE: 1"=10'

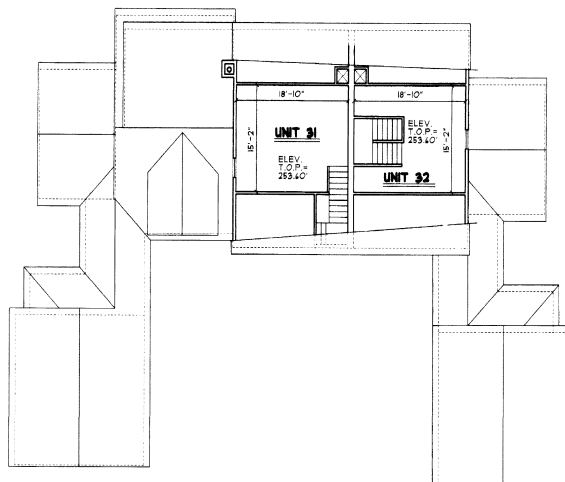


THIRD FLOOR (LOFT) PLAN

SCALE: 1"=10'

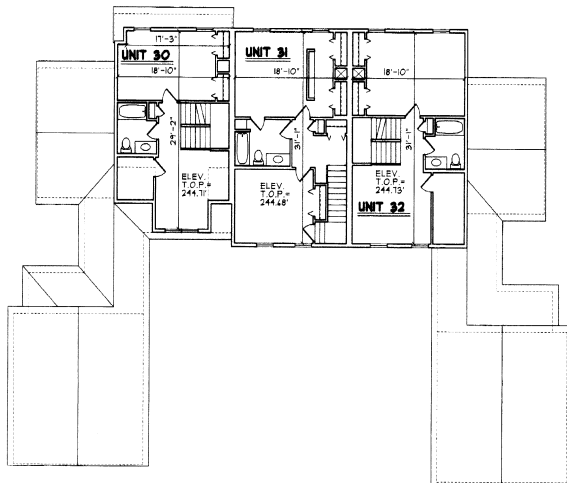


SECOND FLOOR PLAN

SCALE: 1"=10'

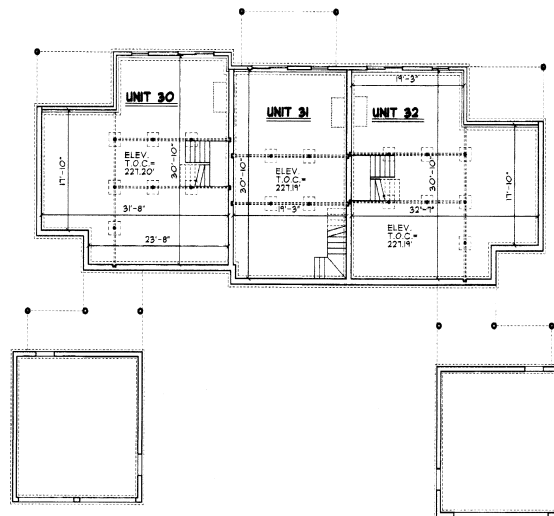


BASEMENT PLAN

SCALE: 1"=10'

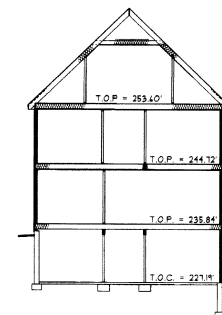

CROSS SECTION A

SCALE: 1"=10'

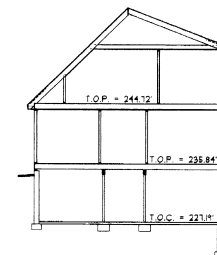

CROSS SECTION B

SCALE: 1"=10'

CERTIFICATION

"I CERTIFY THAT THE UNITS DEPICTED ON THIS PLAN HAVE BEEN SUBSTANTIALLY COMPLETED AND THAT THE FLOOR PLANS SHOWN HEREON ARE ACCURATE AND IN COMPLIANCE WITH THE PROVISIONS OF NEW HAMPSHIRE RSA 356-B: 20, II."

DATE: 4/24/98



AS-BUILT FLOOR PLANS
BUILDING 'G', UNITS 30, 31 & 32

**BUCKMEADOW CONDOMINIUMS
PHASE III**

AMHERST, NEW HAMPSHIRE


PREPARED FOR

CLARK CHAIN PROPERTIES, INC.

P.O. BOX 581 - NASHUA, N.H. 03061

SCALE: 1" = 10'

APRIL 22, 1998

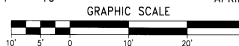

MERIDIAN

Land Services, Inc.

STREET ADDRESS: 31 OLD NASHUA RD. SUITE 2, AMHERST, N.H. 03061 TEL: 603-673-5446 FAX: 603-673-5564
MAILING ADDRESS: PO BOX 18, MILFORD, N.H. 03055-0018 EMAIL: MERIDIAN@AOL.COM
636 DANIEL WEBSTER HWY. PO BOX 501, WETTERMASS, N.H. 03084 TEL: 603-424-0000 FAX: 603-424-4340

ENGINEERS - LAND SURVEYORS - SCIENTISTS - LAND PLANNERS

FILE NO. 2159FLR PROJECT NO. 2159.01 SHEET NO. 1 OF 1

CERTIFICATION

"I CERTIFY THAT THIS SURVEY PLAT IS NOT A SUBDIVISION PURSUANT TO THIS TITLE AND THAT THE LINE OF STREETS AND WAYS SHOWN ARE THOSE OF PUBLIC OR PRIVATE STREETS OR WAYS ALREADY ESTABLISHED AND THAT NO NEW WAYS ARE SHOWN." (RSA 476:18 1/1/96).

DATE: 4-24-98



REV.	DATE	DESCRIPTION	C/O	DR	CK