

IREDELL COUNTY HEALTH DEPARTMENT

Statesville Office (704) 878-5305

Mooresville Office (704) 660-3625

PERMIT #

178444

DPX

IMPROVEMENT PERMIT / AUTHORIZATION TO CONSTRUCT / OPERATION PERMIT / EXISTING SYSTEM

PIN # 4766735349

APPLICANT: Ronald Morrison

APPLICANT ADDRESS: 155 Heathrow Lane

SITE ADDRESS: 204 Seven Springs Loop

PHONE: 704-902-4760 ALT. PHONE: N/A

SITE DIRECTIONS: Hwy 64 E TL old Mocksville Rd TR Chestnut Grove Rd. TR Seven Springs Loop

SUBDIVISION: Seven Springs

SECTION: N/A LOT # 85 LOT AREA: .77 acres


DESIGN FLOW: 360 gpd L.T.A.R.: Existing

Septic Tank <u>Existing</u> (gal)	STB	Date	☐ New System ☐ Repair ☐ Expansion	System Type: I II III IV V VI	☒ Residence	No. Bedrooms <u>3</u>	Water Supply
Pump Tank (gal)	PT	Date	System Description: <u>25% Reduction</u>		☐ Business	No. Persons	☐ Private
Pump Make	Model	Serial #	Repair System Description: <u>Low Pressure 50%</u>		☐ Other	No. Employees	☒ Public
# Nitrification Fields <u>Gx</u>	# Lines <u>5</u>	Linear Ft. <u>Gx</u>	Maintenance Agreement Required: ☐ YES ☒ NO		☐ Slab	☒ Crawl Space	☐ Community
Trench Width <u>Gx</u>	Max. Trench Bottom Depth <u>Gx</u>	Gravel Depth <u>Gx</u>	☒ GRAVITY ☐ PRESSURE		☐ Basement w/plumbing	☐ Basement w/o plumbing	


Comments / Conditions:

Maintain a minimum of 15' between pool and all components of septic tank system + repair areas.

INITIAL SITE SKETCH

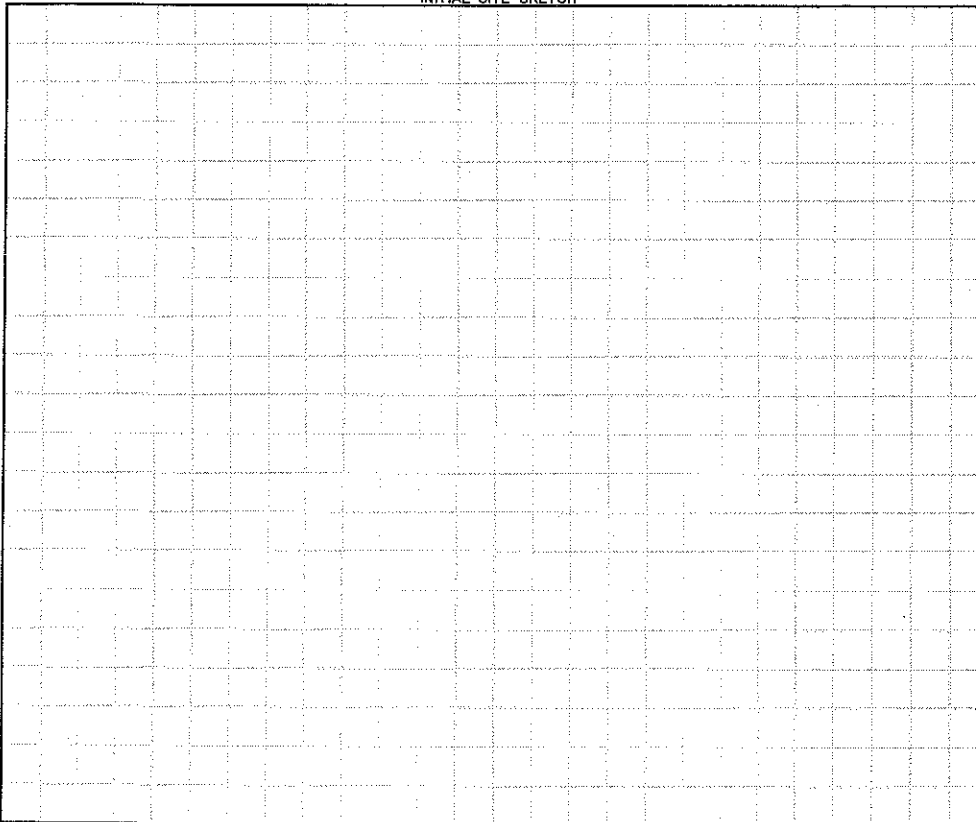

AS BUILT SKETCH

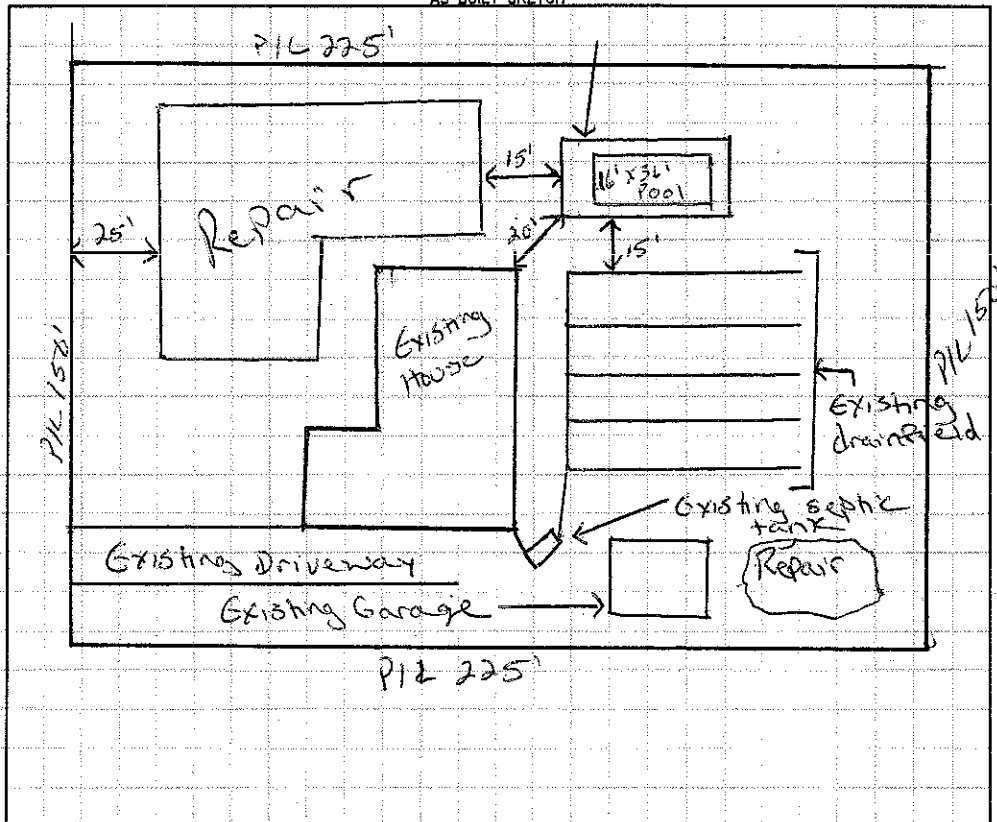

Permit can be suspended or revoked if any false information is supplied toward securing the permit / any unauthorized changes are made to the site / any unauthorized changes are made in the installation of the system. **CONTACT A LOCATOR SERVICE PRIOR TO ANY EXCAVATION**

☐ IMPROVEMENT PERMIT with plat valid without expiration.

☐ IMPROVEMENT PERMIT with site plan valid for 60 mos.

☐ AUTHORIZATION TO CONSTRUCT valid for period equal to IMPROVEMENT PERMIT--not to exceed 60 mo.

Owner / Applicant Signature: Jamie Morrison

Date: 5-9-13

Installed by:

IMPROVEMENT PERMIT by:

Date:

OPERATION PERMIT by:

Date:

AUTHORIZATION TO CONSTRUCT by:

Date:

Existing System Inspected by: Justin Henderson

Date: 5-8-13