CLARK COUNTY PUBLIC HEALTH
1601 E. Fourth Plain Blvd. • PO Box 9825
Vancouver, WA 98666-8825
(360) 397-8428 • Fax (360) 397-8084

* 6 2 3 7 6 2 *

PLOT PLAN

PERMIT DATE: 11-23-10

OSS TYPE: P.D. ID# SR 0014074

PROPERTY ADDRESS / LOCATION : 4115 NE 259th ST

PERMIT ISSUED TO: WALT HOUSER BETHANY VINEYARDS PHONE#

DESIGNER'S NAME: CORY MCNAIR PHONE# 907-1576

DESIGNER'S ADDRESS: 18914 NE 164 ST BRUSH PRAIRIE

INSTALLER'S NAME: L+S CONTRACTORS PHONE# 686-3827

INSTALLER'S ADDRESS: 22405 NE GANNER RD YACOLT WA 98675

Note: This is a permanent record. Please use a straight edge to prepare an accurate detailed drawing of the constructed OSS system, drawn to scale.

OR locations triangulated, including the following required information:

- Location of all roads/driveways.
- Triangulate the location in feet and inches of all septic / pump tank lids and distribution boxes unless risers are installed to the surface and noted on the as-built. Please use a sidebar box instead of drawing lines through the OSS. Label 2 permanent points as A and B.
- Triangulate both ends of all drainfield laterals unless observation ports are installed to the surface at both ends of each lateral.
- Show all surface water features, wells, buildings, waterlines, curtain drains, roof infiltration systems, etc. and their distances to the OSS. Identify the Reserve Area and 100% area with length and width dimensions.

OR a to-scale designer CAD drawing, including the above required information.

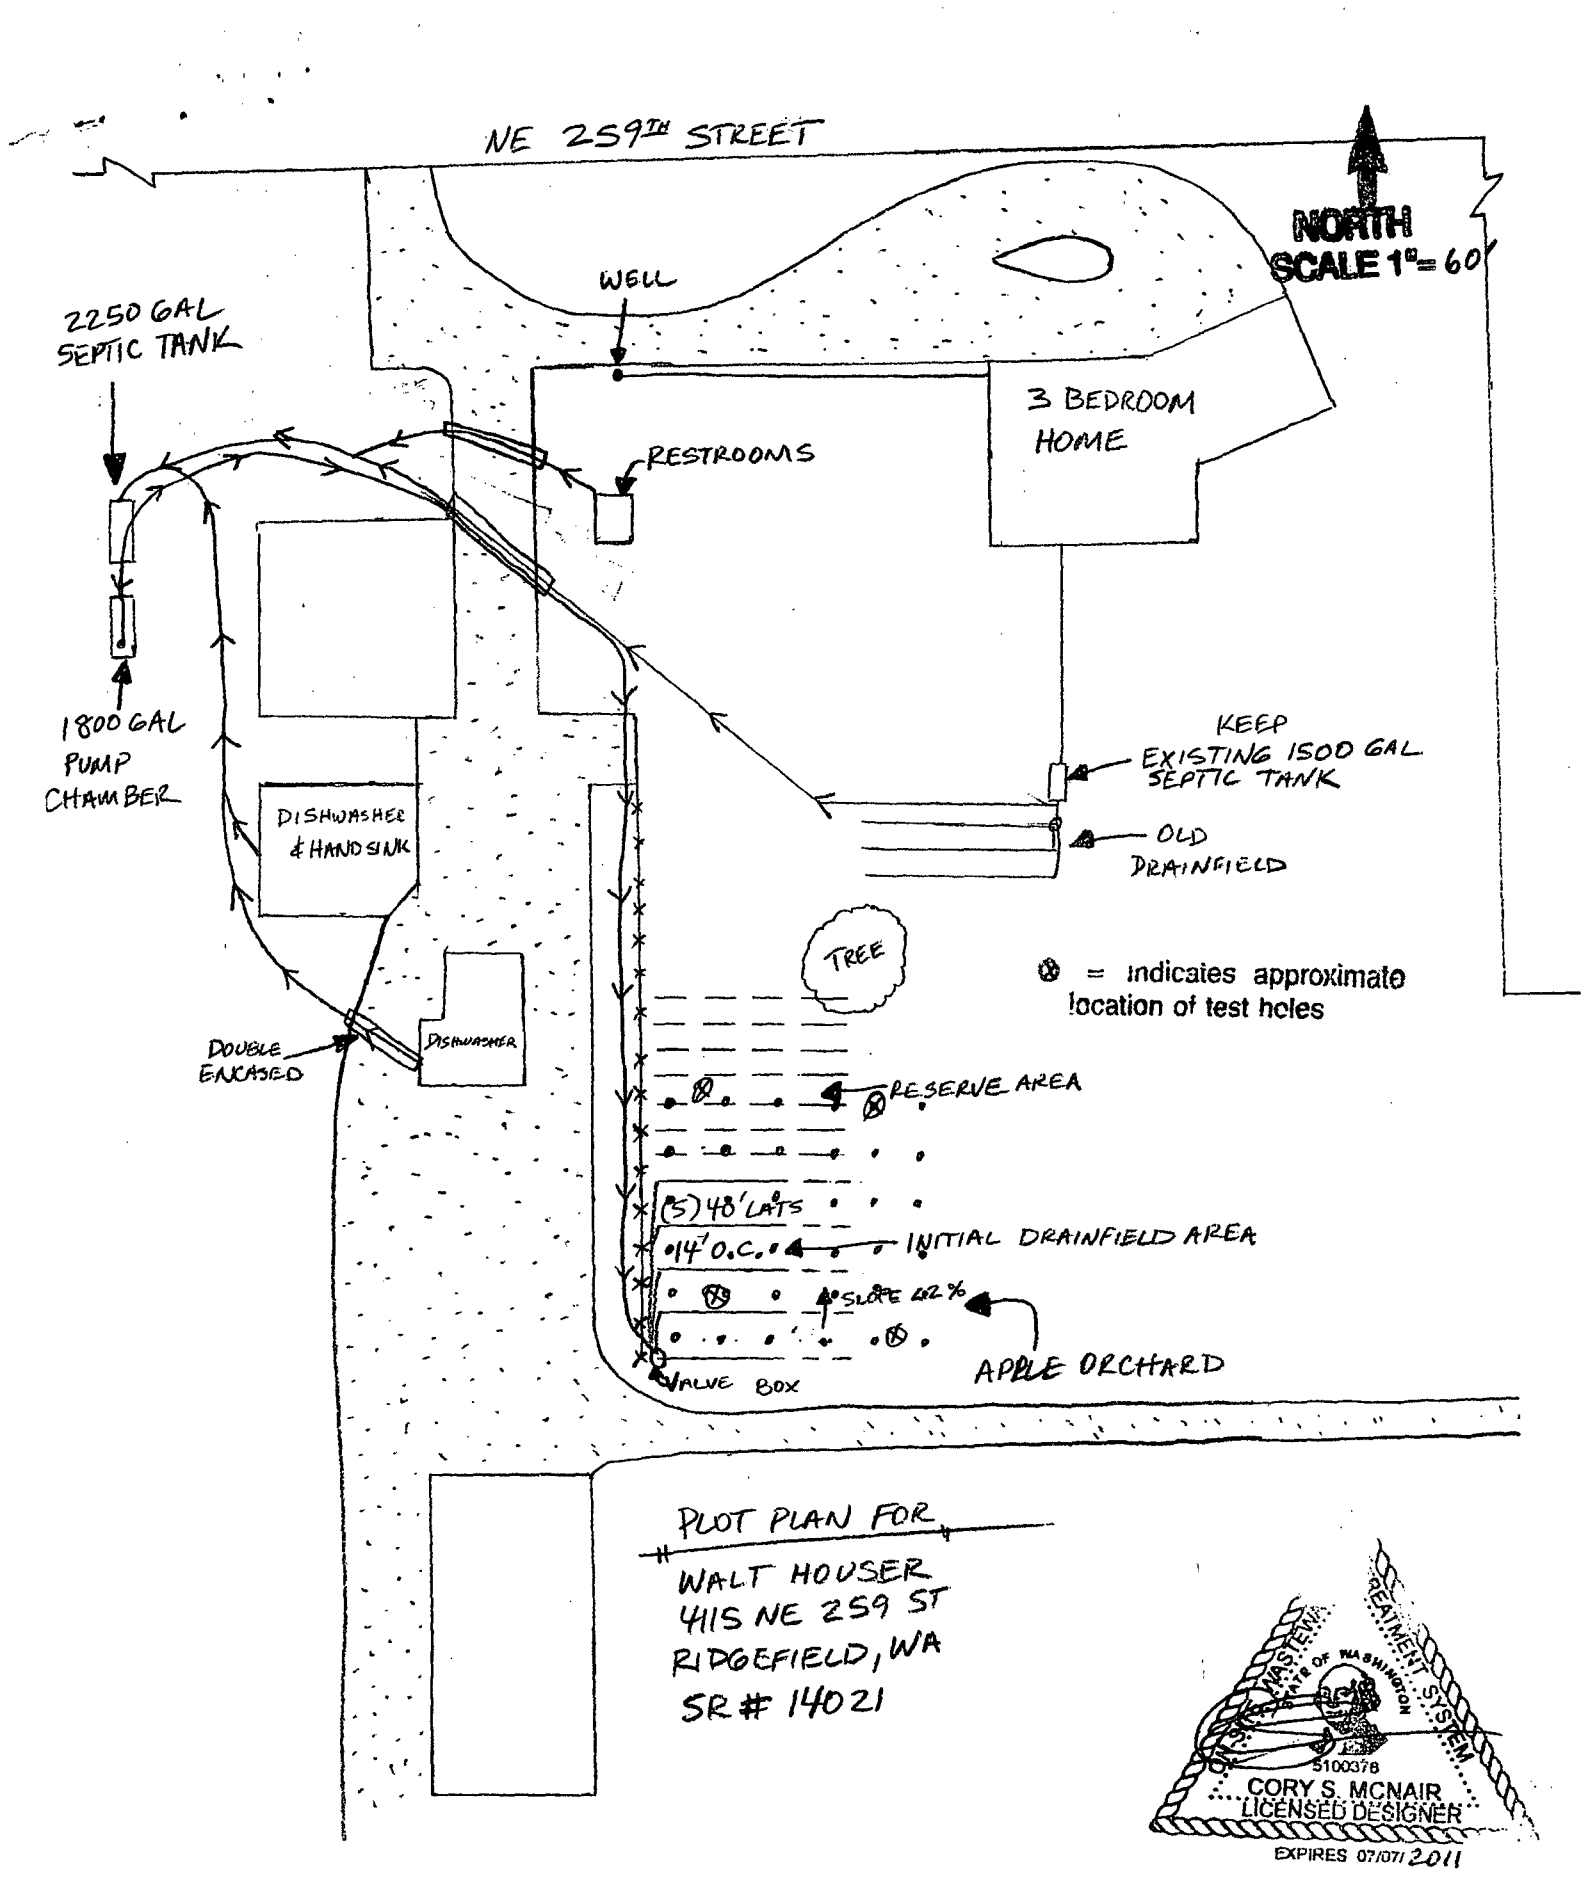


(Designer Stamp Required)
INSTALLER'S SIGNATURE: Basil F. Rotsen DATE: 12-9-2010

FINAL INSPECTION BY DESIGNER: DATE: 12-9-10

-OR-

FINAL INSPECTION BY CCPH: DATE:


NE 259TH STREET
NORTH
SCALE 1"= 60'
WELL
2250 GAL SEPTIC TANK
3 BEDROOM HOME
RESTROOMS
1800 GAL PUMP CHAMBER
KEEP EXISTING 1500 GAL SEPTIC TANK
OLD DRAINFIELD
DISHWASHER & HAND SINK
TREE
⊗ = indicates approximate location of test holes
DOUBLE ENCASED
DISHWASHER
RESERVE AREA
(5) 48' LATS
14' O.C.
INITIAL DRAINFIELD AREA
SLOPE 12%
APPLE ORCHARD
VALVE BOX
PLOT PLAN FOR
WALT HOUSER
4115 NE 259 ST
RIDGEFIELD, WA
SR# 14021
WASTEWATER TREATMENT SYSTEM
STATE OF WASHINGTON
5100378
CORY S. MCNAIR
LICENSED DESIGNER
EXPIRES 07/07/2011